NOTES:

AS BUILT INFORMATION HAS BEEN SUPPLIED BY KBs CONTRACTING & QUARRIES LTD - FEBRUARY 2014.
HEIGHTS ARE IN TERMS OF MEAN SEA LEVEL
ALL LATERALS ARE 20mmØ ID POLY

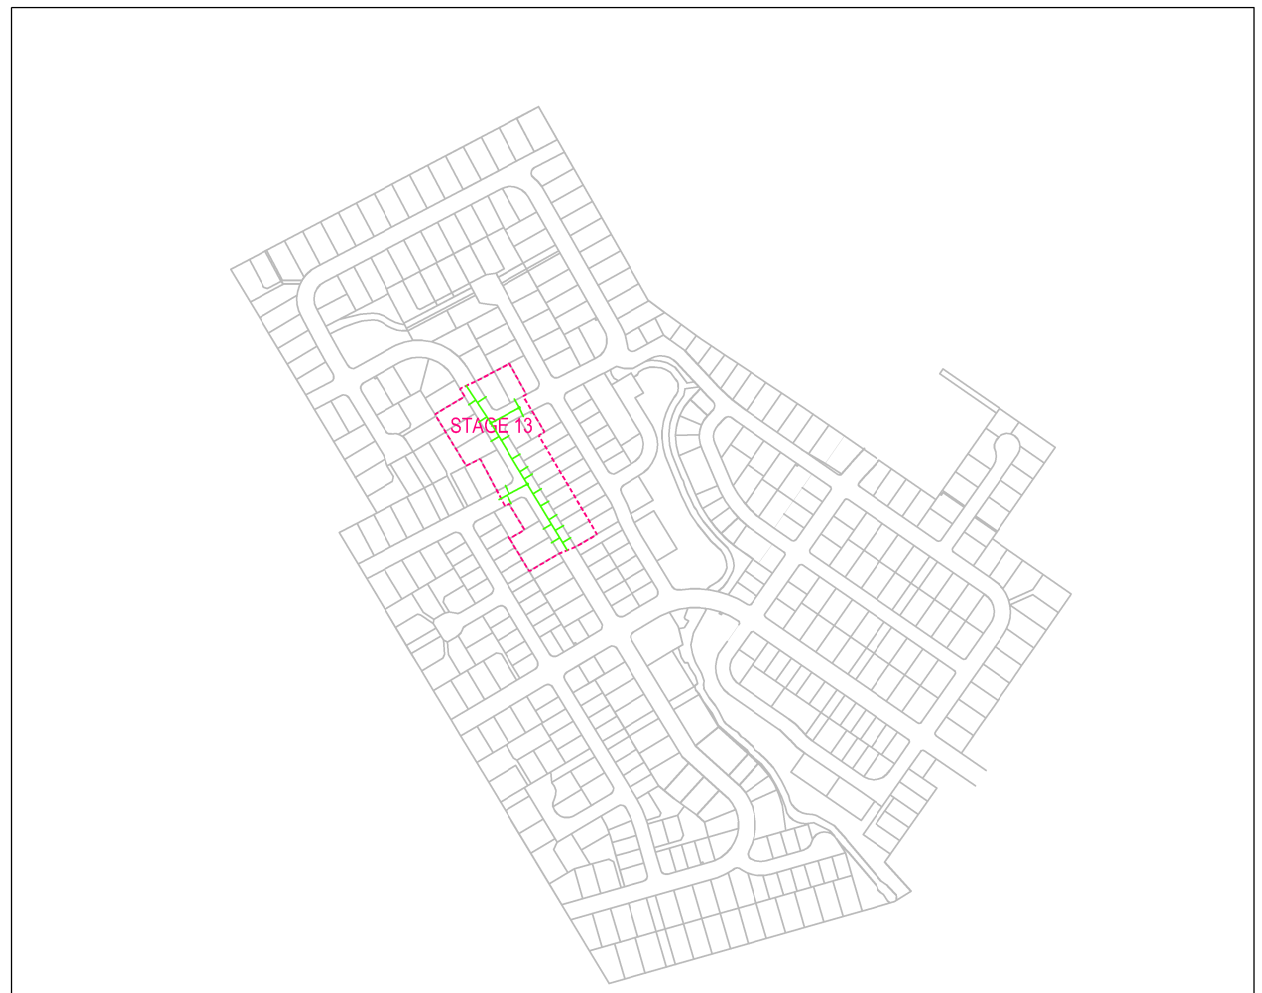

LOCATION PLAN

10 0 20 40m
SCALE 1:1000

80 0 160 320m
SCALE 1:8000

aurecon
www.aurecongroup.com

CLIENT	REV	DATE	REVISION DETAILS	APPROVED
	A	28.02.14	AS BUILTS ISSUED	B.TOMS

DRAWN	DESIGNED
A.GRAY	M.CROWE
CHECKED	
D.WATSON	
APPROVED	DATE
B.TOMS	28.02.14
B.TOMS	

PROJECT
STONEBROOK ROLLESTON
TITLE
STAGE 13 SEWER AS BUILT

AS BUILT	
PROJECT No.	
224926	
SCALE	SIZE
AS SHOWN	A3
DRAWING No.	REV
224926	A