


Road	Options	Name
1	1 Torlesse Drive 2 Garbro Drive 3 Anderite Drive	
2	1 Breccia Place 2 Sandspone Way 3 Siltsbone Way	
3	1 Stonebrook Drive	
4	1 Rynolite Way 2 Felsite Way 3 Bunite Way	
5	1 Arkose Place 2 Perite Place 3 Rynolite Place	
6	1 Chert Place 2 Lignite Place 3 Berocca Place	
7	1 Anderite Way 2 Traverline Street 3 Arkrose Street	
8	1 Alabaster Way 2 Argillite Way 3 Aplite Way	

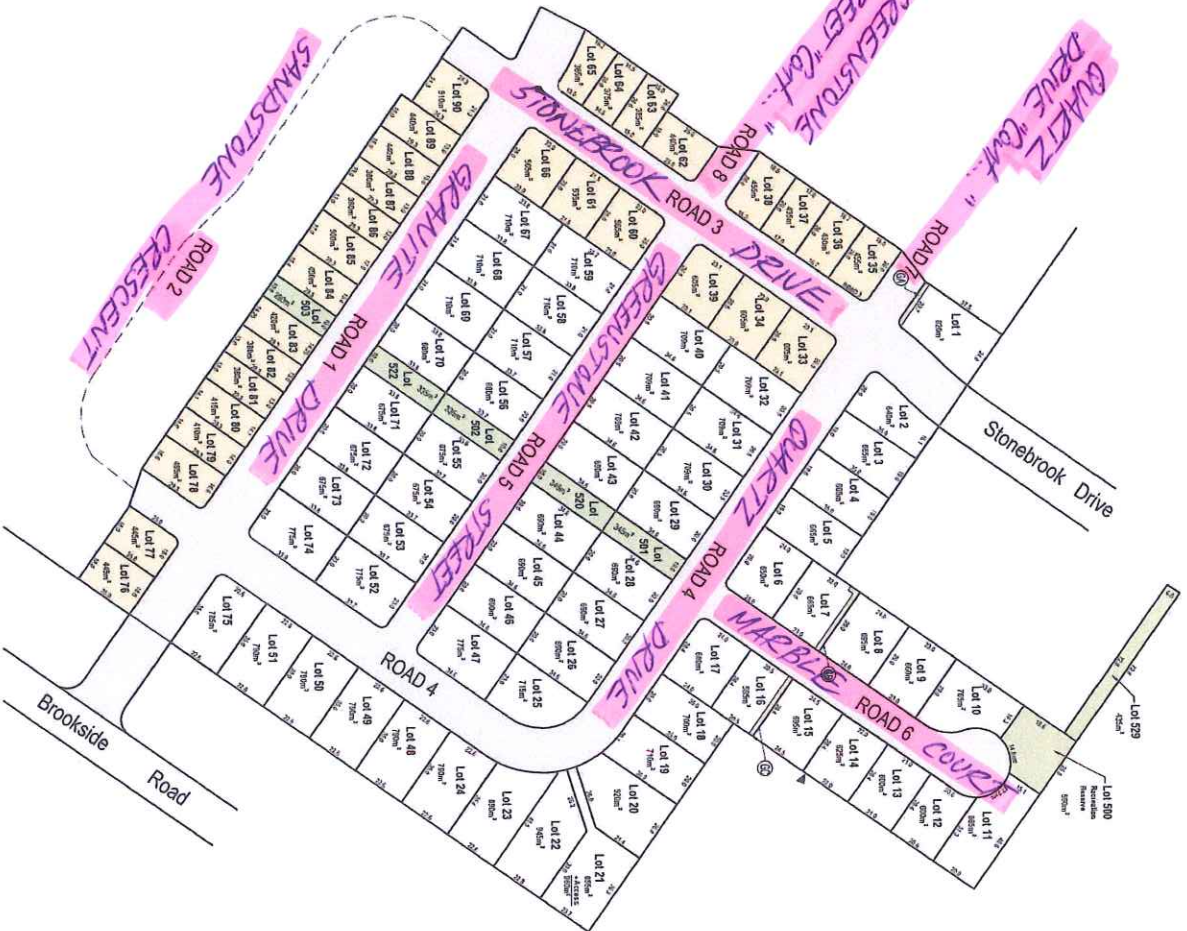

LEGEND

[Symbol]	LIMB Z
[Symbol]	MEDICAL DENSITY
[Symbol]	WALKWAY/RECREATION RESERVE
[Symbol]	ESSENTIAL - (WATER PACE)
[Symbol]	ROADING

NOTES:


FURTHER EASEMENTS MAY BE REQUIRED FOR SERVICES.

PROPOSED HIERARCHY OF EASEMENTS

Name	Let No	System	Dominant	Territory

DATA QUALITY STATEMENTS

PROPERTY DATA:
The property data has been sourced from Land Information New Zealand (LINZ) and is correct as at 31st August 2011.

SURVEYED DATA:
The survey data has been obtained using survey equipment, to a relative accuracy within 1:1000 (horizontal and vertical).

BOUNDARY DATA:

All lot areas and dimensions are subject to final survey.



STONEBROOK