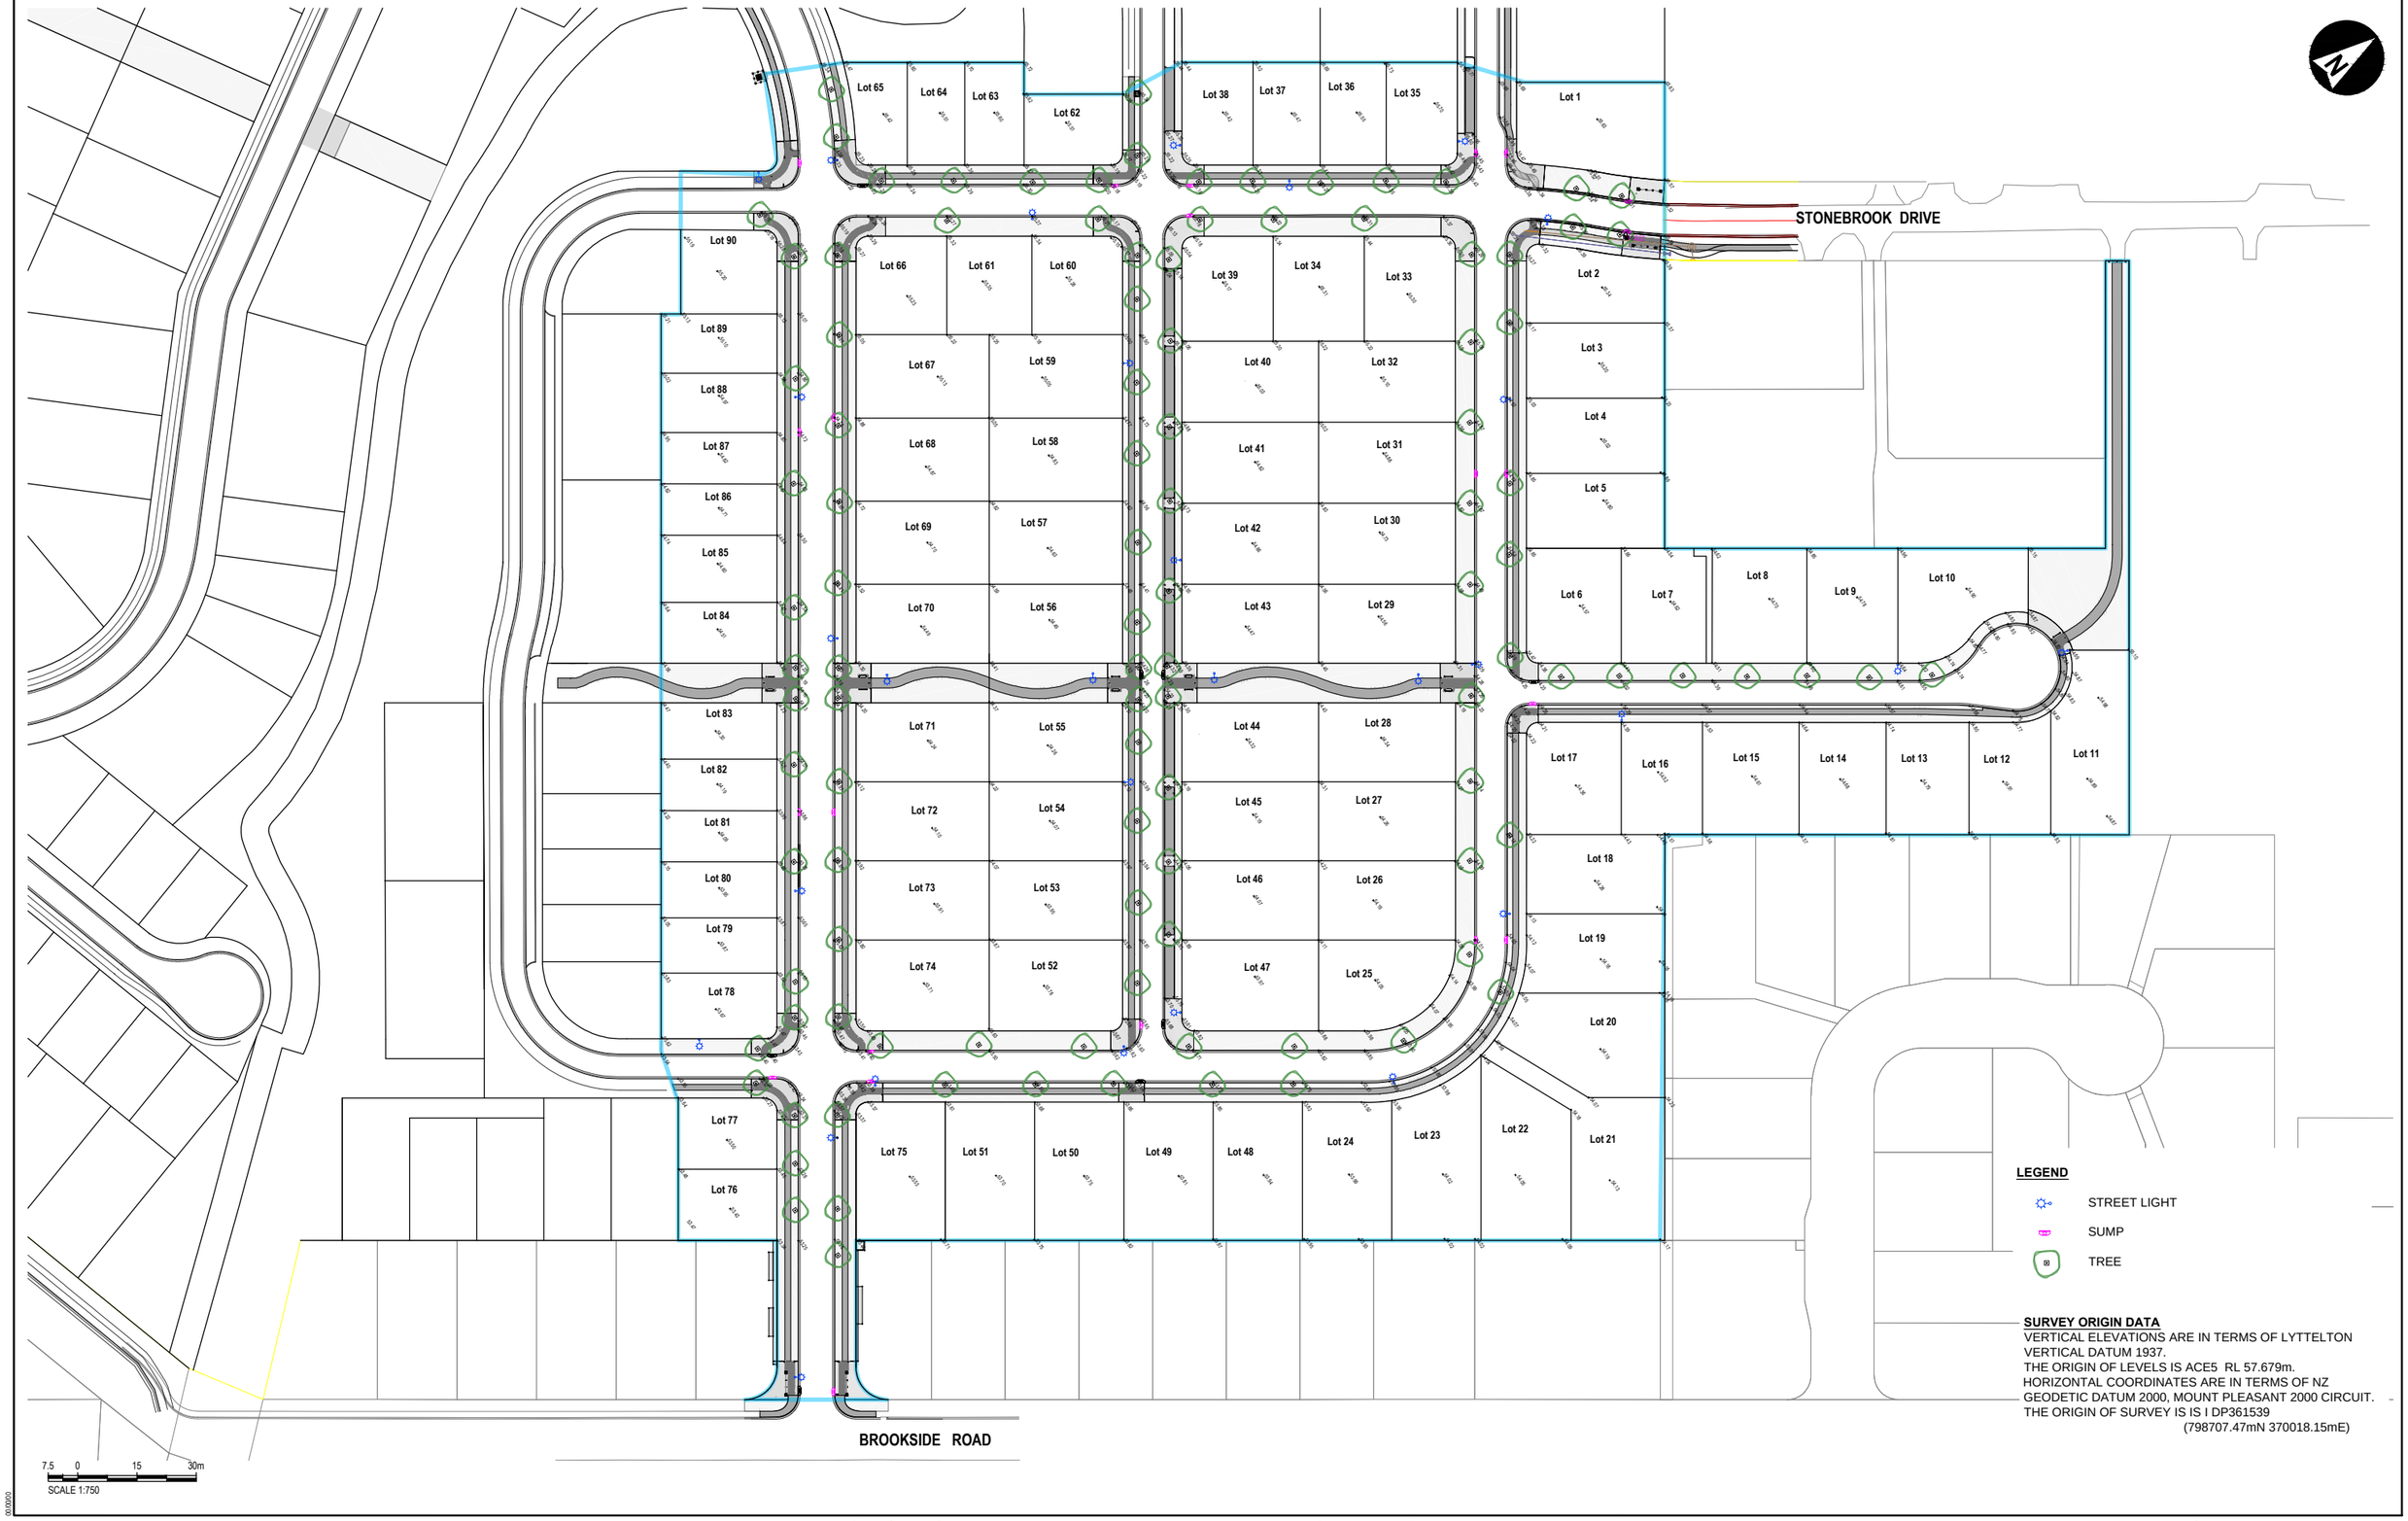

aurecon
www.aurecongroup.com

CLIENT
CDL LAND
NEW ZEALAND LIMITED

REV	DATE	REVISION DETAILS	APPROVED
A	19/07/13	issue	BDT

DRAWN	SURVEYED
R DAWSON	B TOMS

CHECKED
M CROWE

APPROVED
B.D. Toms DATE *19/07/2013*
BD TOMS

PROJECT
STONEBROOK ROLLESTON

TITLE
SITE LEVELS
LOTS 1-90

INFORMATION

PROJECT No.	
224926	
SCALE	SIZE
1:750@A1	A1
DRAWING No.	REV
SU 06	A