NOTES:

AS BUILT INFORMATION HAS BEEN SUPPLIED BY KBs CONTRACTING & QUARRIES LTD - AUGUST 2014.
HEIGHTS ARE IN TERMS OF MEAN SEA LEVEL
ALL LATERALS ARE 20mmØ ID POLY

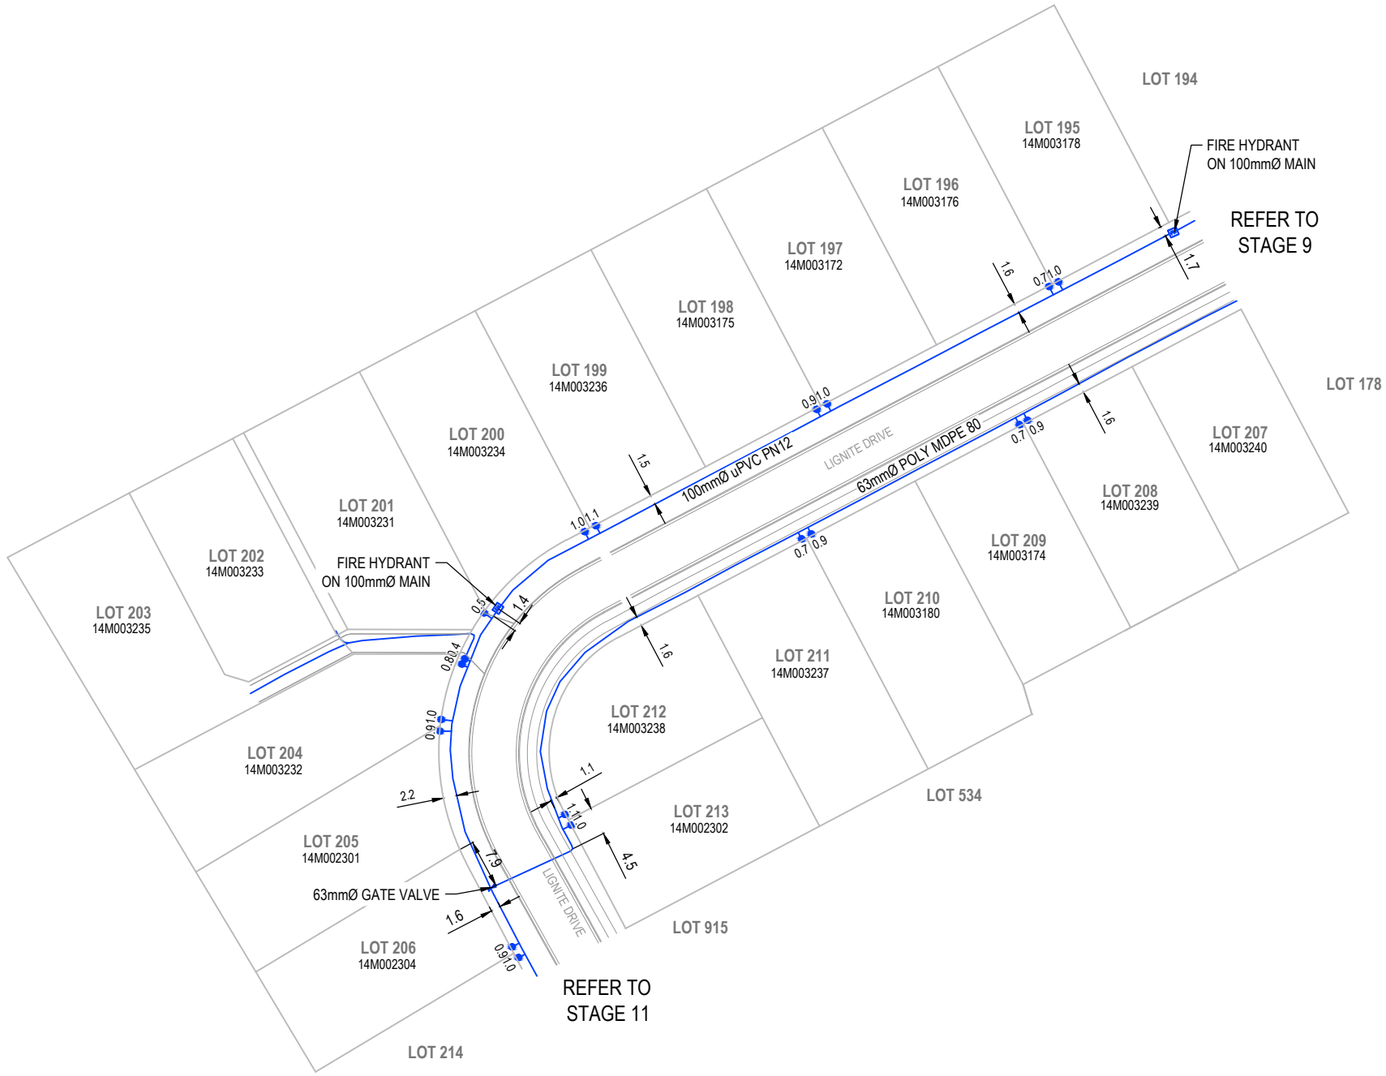

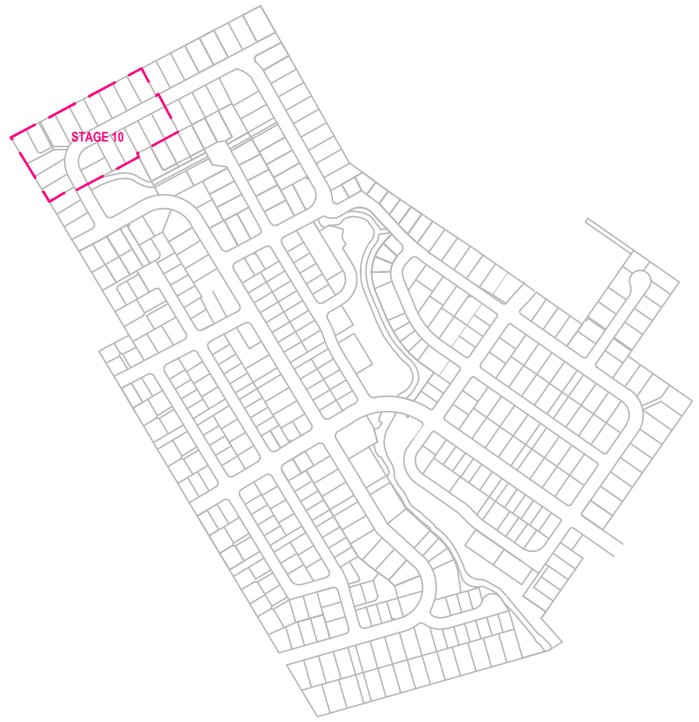

LOCATION PLAN

10 0 20 40m
SCALE 1:1000

80 0 160 320m
SCALE 1:8000

00/00/00

aurecon
www.aurecongroup.com

CLIENT	REV	DATE	REVISION DETAILS	APPROVED
	A	29.10.14	AS BUILTS ISSUED	B.TOMS

DRAWN	DESIGNED
A.COLUMBUS	M.CROWE
CHECKED	
D.WATSON	
APPROVED	
B.TOMS	DATE *29.10.14*
B.TOMS	

PROJECT
STONEBROOK ROLLESTON

TITLE
STAGE 10
WATER
AS BUILT

AS BUILT

PROJECT No.
224926

SCALE	SIZE
AS SHOWN	A3
DRAWING No.	REV
DW-LD-S10-AB-W-01	A