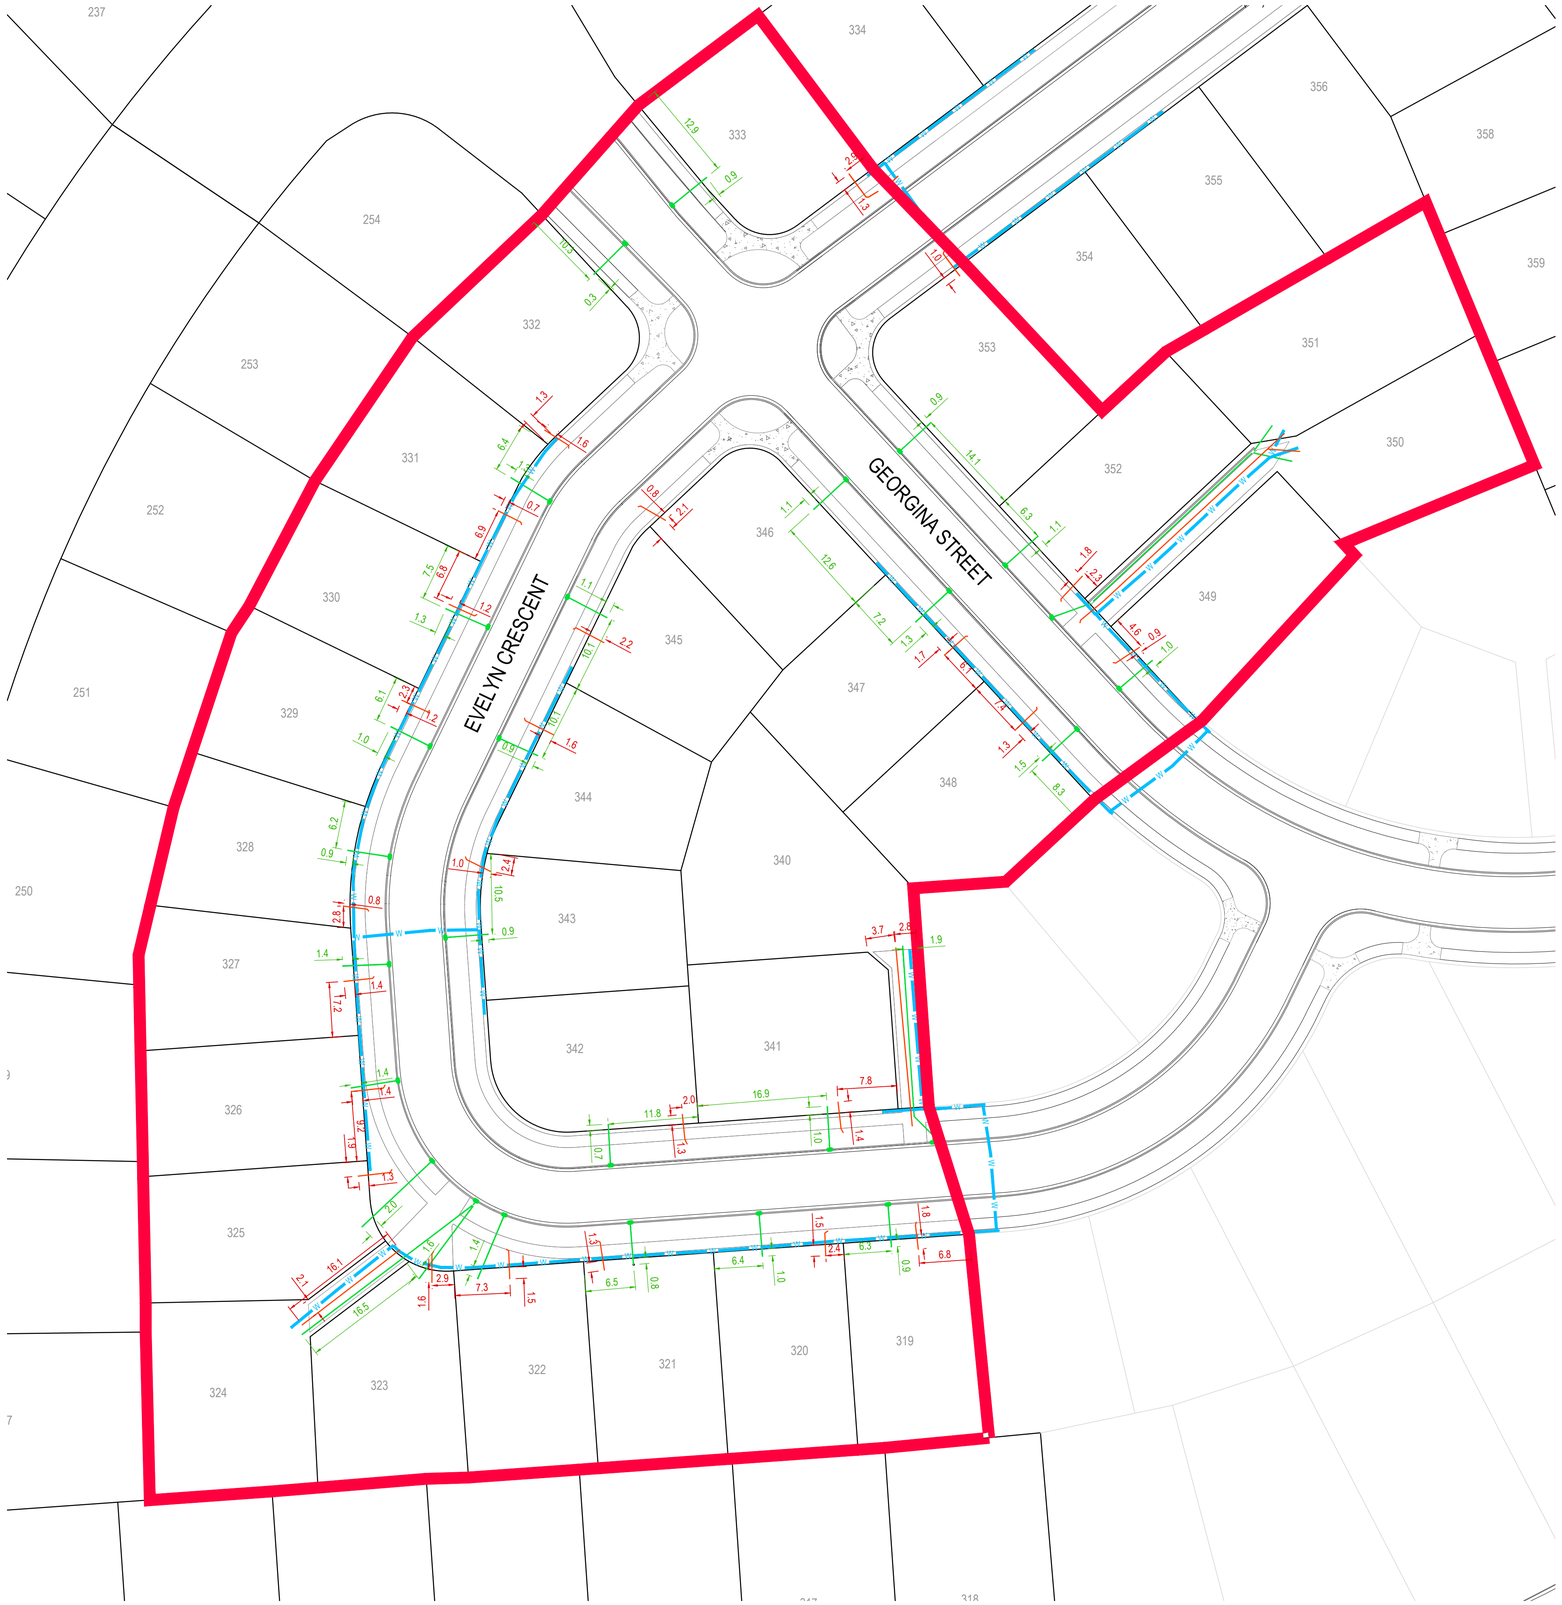

LEGEND

- SUB-STAGE BOUNDARY
- STORMWATER TO STREET
- SEWER LATERAL TO MAINS
- WATER SUBMAIN

aurecon

www.aurecongroup.com

CLIENT

CDL LAND
NEW ZEALAND LIMITED

REV	DATE	REVISION DETAILS	APPROVED
A		ISSUE FOR INFORMATION	K ASHBY

PROJECT

PRESTONS PARK

TITLE

AS-BUILT SEWER AND STORMWATER
SUBSTAGE S1
STAGE 2

DRAWN	DESIGNED
M KORAKO	C DOHERTY
CHECKED	
D ROBINS	
APPROVED	
DATE	
K ASHBY	

PRELIMINARY
NOT FOR CONSTRUCTION

PROJECT No.	
235361	
SCALE	**SIZE**
1:400	A1
DRAWING No.	**REV**
AB-PS-S2-SP-15	A