



Eagle Technology, Land Information New Zealand, GEBCO, Community maps contributors

LEGEND
◆ NDM TEST LOCATION



NOTE:
A selection of NDM test points only has been shown due to NDM testing density. Full details of all NDM test results are provided in 235361 - Prestons Park Subdivision Stage E3 Geotechnical Completion Report




REV	DATE	REVISION DETAILS	APPROVED
A	17/10/22	ISSUE FOR INFORMATION	J. Kupec

DRAWN	DESIGNED
R.Dawson	C. Scott
CHECKED	DATE
J. Muirson	17/10/2022
APPROVED	
J. Kupec	

PROJECT
PRESTONS PARK SUB-STAGE E3
TITLE
NDM LOCATIONS

PROJECT No.
235361
SCALE
AS SHOWN
DRAWING No.
FIG 4
REV
A

Path: C:\Users\Ros.Dawson\Desktop\prestons\GIS\STAGE 5\E3\FIG 4 NDM.mxd

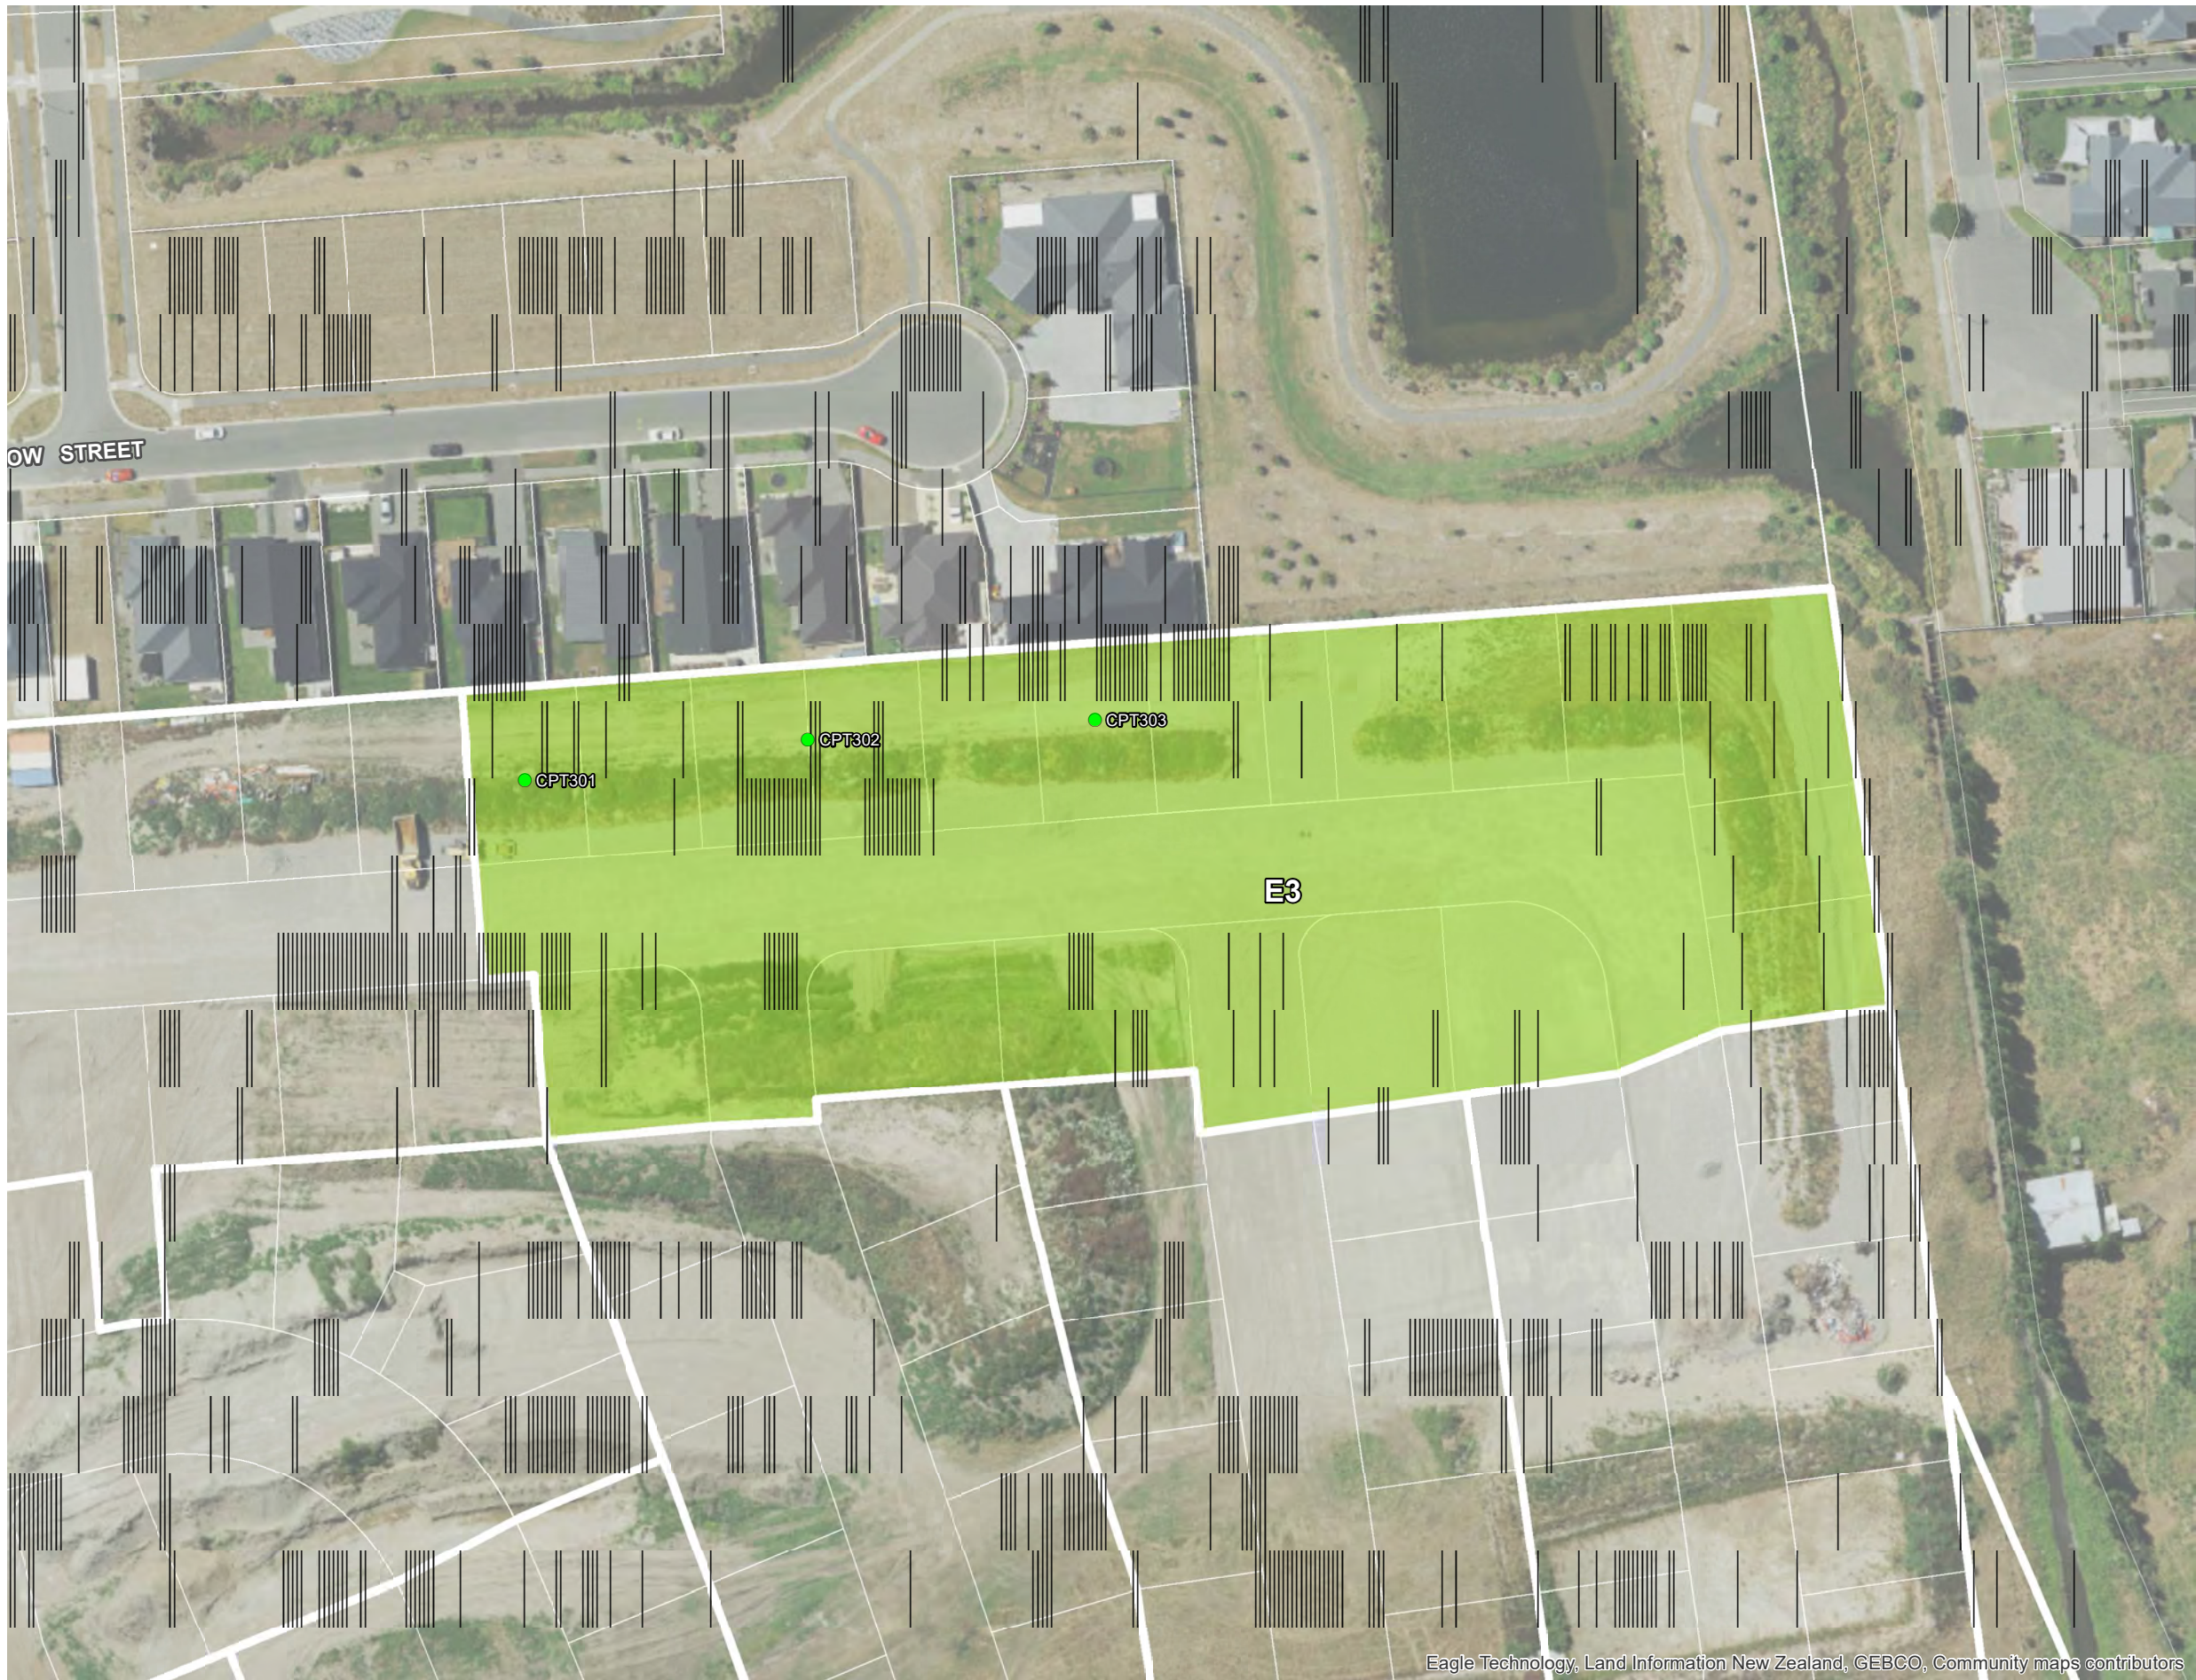

Eagle Technology, Land Information New Zealand, GEBCO, Community maps contributors

LEGEND

● POST EARTHWORKS CPT

aurecon
www.aurecongroup.com



REV	DATE	REVISION DETAILS	APPROVED
A	17/10/22	ISSUE FOR INFORMATION	J. Kupec

DRAWN	DESIGNED
R.Dawson	C. Scott
CHECKED	
J. Muirson	
APPROVED	
J. Kupec	17/10/22

PROJECT
PRESTONS SOUTH SUB-STAGE E3
TITLE
POST EARTHWORKS CPTS

PROJECT No.	235361	SIZE
SCALE	AS SHOWN	A3
DRAWING No.	FIG 5	REV
		A

Path: C:\Users\Ros.Dawson\Desktop\prestons\GIS\STAGE 5\E3\FIG 5 POST EARTHWORKS CPTS.mxd



NOTE

TECHNICAL CATEGORY CLASSIFICATION HAS BEEN ASSESSED
IN ACCORDANCE WITH SECTION 3 OF THE MBIE
GUIDELINES (2012)

LEGEND

- TC1 EQUIVALENT BEHAVIOUR
- TC2 EQUIVALENT BEHAVIOUR



0 10 20 30 40 Meters

NOTES - PROPERTY DATA FROM LINZ

aurecon
www.aurecongroup.com



REV	DATE	REVISION DETAILS	APPROVED
A	17/10/22	ISSUE FOR INFORMATION	J. Kupec

DRAWN	DESIGNED
R. Dawson	C. Scott
CHECKED	
J. Muirson	
APPROVED	
	DATE
J. Kupec	17/10/2022

PROJECT		PROJECT No.
PRESTONS PARK - SUBSTAGE E3		235361
TITLE		SCALE
TECHNICAL CATEGORY PLAN		AS SHOWN
DRAWING No.		SIZE
FIG 6		A3
REV		
		A

Path: C:\Users\Ros.Dawson\Desktop\prestons\GIS\South Stage 5\E3\FIG 6 TECHNICAL CATEGORY PLAN.mxd