NOTES:

AS BUILT INFORMATION HAS BEEN SUPPLIED BY KBs CONTRACTING & QUARRIES LTD - DECEMBER 2014.
HEIGHTS ARE IN TERMS OF MEAN SEA LEVEL

RS = ROAD SUMP IN SDC LOW PROFILE KERB AND CHANNEL

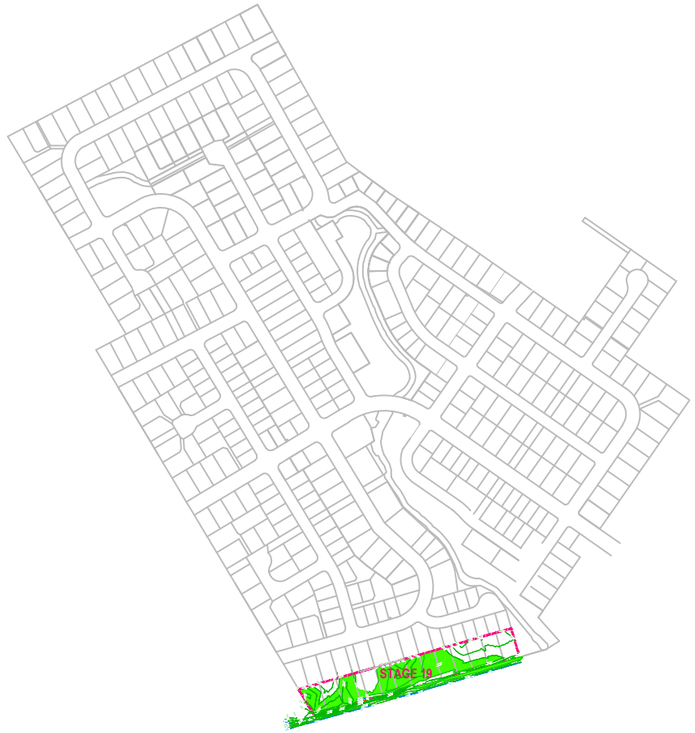

LOCATION PLAN

80 0 160 320m

SCALE 1:8000

10 0 20 40m

SCALE 1:1000

00/00/00

aurecon
www.aurecongroup.com

CLIENT	REV	DATE	REVISION DETAILS	APPROVED
	A	05.12.14	AS BUILTS ISSUED	B.TOMS

DRAWN	DESIGNED
A.COLUMBUS	M.CROWE
CHECKED	
D.WATSON	
APPROVED	DATE
B.TOMS	

PROJECT
STONEBROOK ROLLESTON

TITLE
STAGE 19
FILL
AS BUILT

AS BUILT

PROJECT No.
224926

SCALE	SIZE
AS SHOWN	A3
DRAWING No.	REV
DW-LD-S19-AB-CF-01	A