

Project Prestons South Subdivision
Project No. 235361
Date 29-Nov-19
Title Summary of Compaction

COORDINATES LINKED TO TAB										Pass (Yes/No)			
Test Date	Test ID#	Test #	Unique ID#	mE	mN	Stage	MDD	Type	Lift #	Lot ID	Compaction (%)	Retest	Pass (Yes/No)
9/06/2022	K822/0215	4	611	395938.734	811930.279	Stage 5	2320	Pitrun	Lift 6	Gravel Embankment - Lot 1017	99		YES
14/06/2022	K822/0227	6	617	395945.818	811933.152	Stage 5	2320	Pitrun	Lift 7	Gravel Embankment - Lot 1017	100		YES
14/01/2022	K822/0003	15	873	395964.337	811935.381	Stage 5	2320	Pt Run	Lift 1	Gravel Embankment - Lot 1018	99		YES
14/01/2022	K822/0003	16	874	395966.179	811949.06	Stage 5	2320	Pit Run	Lift 1	Gravel Embankment - Lot 1018	99		YES
1/06/2022	K822/0201	5	546	395962.4	811939.579	Stage 5	2320	Pitrun	Lift 1	Gravel Embankment - Lot 1018	99		YES
8/06/2022	K822/0209	1	573	395962.4	811939.579	Stage 5	2320	Pitrun	Lift 1	Gravel Embankment - Lot 1018	98		YES
1/06/2022	K822/0202	5	551	395962.4	811939.579	Stage 5	2320	Pitrun	Lift 2	Gravel Embankment - Lot 1018	99		YES
8/06/2022	K822/0210	1	577	395962.4	811939.579	Stage 5	2320	Pitrun	Lift 2	Gravel Embankment - Lot 1018	102		YES
2/06/2022	K822/0203	5	556	395962.4	811939.579	Stage 5	2320	Pitrun	Lift 3	Gravel Embankment - Lot 1018	104		YES
9/06/2022	K822/0212	1	596	395962.4	811939.579	Stage 5	2320	Pitrun	Lift 3	Gravel Embankment - Lot 1018	103		YES
3/06/2022	K822/0205	5	585	395962.4	811939.579	Stage 5	2320	Pitrun	Lift 4	Gravel Embankment - Lot 1018	104		YES
9/06/2022	K822/0213	1	600	395962.4	811939.579	Stage 5	2320	Pitrun	Lift 4	Gravel Embankment - Lot 1018	104		YES
3/06/2022	K822/0206	5	590	395962.4	811939.579	Stage 5	2320	Pitrun	Lift 5	Gravel Embankment - Lot 1018	103		YES
9/06/2022	K822/0214	1	604	395962.4	811939.579	Stage 5	2320	Pitrun	Lift 5	Gravel Embankment - Lot 1018	103		YES
3/06/2022	K822/0207	5	595	395962.4	811939.579	Stage 5	2320	Pitrun	Lift 6	Gravel Embankment - Lot 1018	98		YES
9/06/2022	K822/0215	1	608	395962.4	811939.579	Stage 5	2320	Pitrun	Lift 6	Gravel Embankment - Lot 1018	98		YES
25/06/2021	K821/0195	1	477	396018.63	811970.311	Stage 5	2380	Pitrun	Lift 1	Gravel Embankment - Lot 1020	96		YES
25/06/2021	K821/0195	2	478	396008.618	811956.323	Stage 5	2380	Pitrun	Lift 1	Gravel Embankment - Lot 1020	96		YES
1/06/2022	K822/0201	1	542	396008.618	811956.323	Stage 5	2320	Pitrun	Lift 1	Gravel Embankment - Lot 1020	98		YES
25/06/2021	K821/0196	1	487	396018.63	811970.311	Stage 5	2380	Pitrun	Lift 2	Gravel Embankment - Lot 1020	95		YES
25/06/2021	K821/0196	2	488	396008.618	811956.323	Stage 5	2380	Pitrun	Lift 2	Gravel Embankment - Lot 1020	96		YES
1/06/2022	K822/0202	1	547	396008.618	811956.323	Stage 5	2320	Pitrun	Lift 2	Gravel Embankment - Lot 1020	96		YES
25/06/2021	K821/0197	1	479	396018.63	811970.311	Stage 5	2380	Pitrun	Lift 3	Gravel Embankment - Lot 1020	96		YES
25/06/2021	K821/0197	2	480	396008.618	811956.323	Stage 5	2380	Pitrun	Lift 3	Gravel Embankment - Lot 1020	96		YES
2/06/2022	K822/0203	1	552	396008.618	811956.323	Stage 5	2320	Pitrun	Lift 3	Gravel Embankment - Lot 1020	106		YES
30/06/2021	K821/0199	5	470	396008.618	811956.323	Stage 5	2380	Pitrun	Lift 4	Gravel Embankment - Lot 1020	96		YES
3/06/2022	K822/0205	1	581	396008.618	811956.323	Stage 5	2320	Pitrun	Lift 4	Gravel Embankment - Lot 1020	105		YES
1/07/2021	K821/0200	5	465	396008.618	811956.323	Stage 5	2380	Pitrun	Lift 5	Gravel Embankment - Lot 1020	96		YES
3/06/2022	K822/0206	1	586	396008.618	811956.323	Stage 5	2320	Pitrun	Lift 5	Gravel Embankment - Lot 1020	106		YES
1/07/2021	K821/0201	5	450	396008.618	811956.323	Stage 5	2380	Pitrun	Lift 6	Gravel Embankment - Lot 1020	95		YES
3/06/2022	K822/0207	1	591	396008.618	811956.323	Stage 5	2320	Pitrun	Lift 6	Gravel Embankment - Lot 1020	100		YES
2/07/2021	K821/0203	5	460	396008.618	811956.323	Stage 5	2380	Pitrun	Lift 7	Gravel Embankment - Lot 1020	96		YES
14/06/2022	K822/0227	1	612	396008.618	811956.323	Stage 5	2320	Pitrun	Lift 7	Gravel Embankment - Lot 1020	101		YES
2/07/2021	K821/0208	5	455	396008.618	811956.323	Stage 5	2380	Pitrun	Lift 8	Gravel Embankment - Lot 1020	96		YES
5/07/2021	K821/0209	5	537	396008.618	811956.323	Stage 5	2380	Pitrun	Lift 9	Gravel Embankment - Lot 1020	97		YES
24/06/2021	K821/0190	4	502	396026.287	811983.121	Stage 5	2380	Pitrun	Lift 1	Gravel Embankment - Lot 1021	95		YES
24/06/2021	K821/0191	4	492	396026.287	811983.121	Stage 5	2380	Pitrun	Lift 2	Gravel Embankment - Lot 1021	97		YES
24/06/2021	K821/0192	4	541	396026.287	811983.121	Stage 5	2380	Pitrun	Lift 3	Gravel Embankment - Lot 1021	96		YES
24/06/2021	K821/0190	1	499	396026.729	812013.6	Stage 5	2380	Pitrun	Lift 1	Gravel Embankment - Lot 1022	97		YES
24/06/2021	K821/0191	1	489	396026.729	812013.6	Stage 5	2380	Pitrun	Lift 2	Gravel Embankment - Lot 1022	96		YES
24/06/2021	K821/0192	1	538	396026.729	812013.6	Stage 5	2380	Pitrun	Lift 3	Gravel Embankment - Lot 1022	97		YES
30/06/2021	K821/0199	1	466	396026.729	812013.6	Stage 5	2380	Pitrun	Lift 4	Gravel Embankment - Lot 1022	96		YES
1/07/2021	K821/0200	1	461	396026.729	812013.6	Stage 5	2380	Pitrun	Lift 5	Gravel Embankment - Lot 1022	96		YES
1/07/2021	K821/0201	1	446	396026.729	812013.6	Stage 5	2380	Pitrun	Lift 6	Gravel Embankment - Lot 1022	97		YES
2/07/2021	K821/0203	1	456	396026.729	812013.6	Stage 5	2380	Pitrun	Lift 7	Gravel Embankment - Lot 1022	95		YES
2/07/2021	K821/0208	1	451	396026.729	812013.6	Stage 5	2380	Pitrun	Lift 8	Gravel Embankment - Lot 1022	96		YES
5/07/2021	K821/0209	1	533	396026.729	812013.6	Stage 5	2380	Pitrun	Lift 9	Gravel Embankment - Lot 1022	98		YES
14/06/2021	K821/0173	6	532	396022.528	812022.843	Stage 5	2380	Pitrun	Lift 1	Gravel Embankment - Lot 1023	97		YES
14/06/2021	K821/0174	6	526	396022.528	812022.843	Stage 5	2380	Pitrun	Lift 2	Gravel Embankment - Lot 1023	96		YES
14/06/2021	K821/0175	6	520	396022.528	812022.843	Stage 5	2380	Pitrun	Lift 3	Gravel Embankment - Lot 1023	96		YES
15/06/2021	K821/0176	6	514	396022.528	812022.843	Stage 5	2380	Pitrun	Lift 4	Gravel Embankment - Lot 1023	97		YES
16/06/2021	K821/0178	6	476	396022.528	812022.843	Stage 5	2380	Pitrun	Lift 5	Gravel Embankment - Lot 1023	96		YES
17/06/2021	K821/0181	6	486	396022.528	812022.843	Stage 5	2380	Pitrun	Lift 6	Gravel Embankment - Lot 1023	96		YES
21/06/2021	K821/0186	6	498	396022.528	812022.843	Stage 5	2380	Pitrun	Lift 7	Gravel Embankment - Lot 1023	96		YES

Project Prestons South Subdivision
Project No. 235361
Date 29-Nov-19
Title Summary of Compaction

COORDINATES LINKED TO TAB										Lift #	Lot ID	Compaction (%)	Retest	Pass (Yes/No)
Test Date	Test ID#	Test #	Unique ID#	mE	mN	Stage	MDD	Type						
24/06/2021	K821/0189	6	508	396022.528	812022.843	Stage 5		2380 Pitrun	Lift 8	Gravel Embankment - Lot 1023	97	YES		
14/06/2021	K821/0173	1	527	396013.435	812100.745	Stage 5		2380 Pitrun	Lift 1	Gravel Embankment - Lot 1027	98	YES		
14/06/2021	K821/0174	1	521	396013.435	812100.745	Stage 5		2380 Pitrun	Lift 2	Gravel Embankment - Lot 1027	97	YES		
14/06/2021	K821/0175	1	515	396013.435	812100.745	Stage 5		2380 Pitrun	Lift 3	Gravel Embankment - Lot 1027	96	YES		
15/06/2021	K821/0176	1	509	396013.435	812100.745	Stage 5		2380 Pitrun	Lift 4	Gravel Embankment - Lot 1027	97	YES		
16/06/2021	K821/0178	1	471	396013.435	812100.745	Stage 5		2380 Pitrun	Lift 5	Gravel Embankment - Lot 1027	99	YES		
17/06/2021	K821/0181	1	481	396013.435	812100.745	Stage 5		2380 Pitrun	Lift 6	Gravel Embankment - Lot 1027	96	YES		
21/06/2021	K821/0186	1	493	396013.435	812100.745	Stage 5		2380 Pitrun	Lift 7	Gravel Embankment - Lot 1027	96	YES		
24/06/2021	K821/0189	1	503	396013.435	812100.745	Stage 5		2380 Pitrun	Lift 8	Gravel Embankment - Lot 1027	96	YES		
6/10/2022	K822-0419	1	1017	395936.529	811928.875	Stage 5		2320 Pit Run	Lift 10	Gravel embankment 1017 - 1011	98	YES		
6/10/2022	K822-0419	2	1018	395924.478	811925.164	Stage 5		2320 Pit Run	Lift 10	Gravel embankment 1017 - 1011	98	YES		
6/10/2022	K822-0419	3	1019	395916.09	811920.865	Stage 5		2320 Pit Run	Lift 10	Gravel embankment 1017 - 1011	98	YES		
6/10/2022	K822-0419	4	1020	395910.533	811915.622	Stage 5		2320 Pit Run	Lift 10	Gravel embankment 1017 - 1011	98	YES		
6/10/2022	K822-0419	5	1021	395910.009	811909.121	Stage 5		2320 Pit Run	Lift 10	Gravel embankment 1017 - 1011	98	YES		
6/10/2022	K822-0419	6	1022	395892.534	811901.802	Stage 5		2320 Pit Run	Lift 10	Gravel embankment 1017 - 1011	98	YES		
6/10/2022	K822-0419	7	1023	395881.138	811895.527	Stage 5		2320 Pit Run	Lift 10	Gravel embankment 1017 - 1011	98	YES		
6/10/2022	K822-0419	8	1024	395871.56	811887.434	Stage 5		2320 Pit Run	Lift 10	Gravel embankment 1017 - 1011	98	YES		
6/10/2022	K822-0419	9	1025	395874.958	811880.029	Stage 5		2320 Pit Run	Lift 10	Gravel embankment 1017 - 1011	98	YES		
4/10/2022	K822-0415	1	1008	395936.529	811928.875	Stage 5		2320 Pit Run	Lift 9	Gravel embankment 1017 - 1011	99	YES		
4/10/2022	K822-0415	2	1009	395924.478	811925.164	Stage 5		2320 Pit Run	Lift 9	Gravel embankment 1017 - 1011	100	YES		
4/10/2022	K822-0415	3	1010	395916.09	811920.865	Stage 5		2320 Pit Run	Lift 9	Gravel embankment 1017 - 1011	99	YES		
4/10/2022	K822-0415	4	1011	395910.533	811915.622	Stage 5		2320 Pit Run	Lift 9	Gravel embankment 1017 - 1011	99	YES		
4/10/2022	K822-0415	5	1012	395910.009	811909.121	Stage 5		2320 Pit Run	Lift 9	Gravel embankment 1017 - 1011	99	YES		
4/10/2022	K822-0415	6	1013	395892.534	811901.802	Stage 5		2320 Pit Run	Lift 9	Gravel embankment 1017 - 1011	99	YES		
4/10/2022	K822-0415	7	1014	395881.138	811895.527	Stage 5		2320 Pit Run	Lift 9	Gravel embankment 1017 - 1011	100	YES		
4/10/2022	K822-0415	8	1015	395871.56	811887.434	Stage 5		2320 Pit Run	Lift 9	Gravel embankment 1017 - 1011	100	YES		
4/10/2022	K822-0415	9	1016	395874.958	811880.029	Stage 5		2320 Pit Run	Lift 9	Gravel embankment 1017 - 1011	99	YES		
25/10/2022	K822/0452	1	1036	396028.267	811992.796	Stage 5		2320 Pit Run	Lift 11	Gravel embankment 1021 - 1027	99	YES		
25/10/2022	K822/0452	2	1037	396027.93	812006.182	Stage 5		2320 Pit Run	Lift 11	Gravel embankment 1021 - 1027	98	YES		
25/10/2022	K822/0452	3	1038	396022.528	812022.843	Stage 5		2320 Pit Run	Lift 11	Gravel embankment 1021 - 1027	98	YES		
25/10/2022	K822/0452	4	1039	396020.367	812039.746	Stage 5		2320 Pit Run	Lift 11	Gravel embankment 1021 - 1027	99	YES		
25/10/2022	K822/0452	5	1040	396018.075	812056.244	Stage 5		2320 Pit Run	Lift 11	Gravel embankment 1021 - 1027	98	YES		
25/10/2022	K822/0452	6	1041	396016.628	812071.497	Stage 5		2320 Pit Run	Lift 11	Gravel embankment 1021 - 1027	99	YES		
25/10/2022	K822/0452	7	1042	396014.613	812086.757	Stage 5		2320 Pit Run	Lift 11	Gravel embankment 1021 - 1027	98	YES		
25/10/2022	K822/0452	8	1043	396013.435	812100.745	Stage 5		2320 Pit Run	Lift 11	Gravel embankment 1021 - 1027	99	YES		
26/10/2022	K822/0456	1	1052	396020.367	812039.746	Stage 5		2320 Pit Run	Lift 12	Gravel embankment 1021 - 1027	99	YES		
26/10/2022	K822/0456	2	1053	396018.075	812056.244	Stage 5		2320 Pit Run	Lift 12	Gravel embankment 1021 - 1027	99	YES		
26/10/2022	K822/0456	3	1054	396016.628	812071.497	Stage 5		2320 Pit Run	Lift 12	Gravel embankment 1021 - 1027	98	YES		
26/10/2022	K822/0456	4	1055	396014.613	812086.757	Stage 5		2320 Pit Run	Lift 12	Gravel embankment 1021 - 1027	99	YES		
26/10/2022	K822/0456	5	1056	396013.435	812100.745	Stage 5		2320 Pit Run	Lift 12	Gravel embankment 1021 - 1027	101	YES		
4/05/2022	0791_001 (0744/22)	2	742	395951.276	812023.129	Stage 5		1640 Sand	Final lift?	Lot 1000	96	YES		
4/05/2022	0791_001 (0744/22)	1	741	395936.68	812021.336	Stage 5		1640 Sand	Lift 1	Lot 1000	97	YES		
6/05/2022	0750_001 (0769/22)	3	322	395951.276	812023.129	Stage 5		1560 sand with some peat	Lift 2	Lot 1000	102	YES		
6/05/2022	0750_001 (0769/22)	4	323	395936.68	812021.336	Stage 5		1560 sand with some peat	Lift 2	Lot 1000	104	YES		
4/05/2022	0791_001 (0744/22)	7	747	395947.121	812048.549	Stage 5		1640 Sand	Lift 1	Lot 1001	98	YES		
4/05/2022	0791_001 (0744/22)	8	748	395934.676	812035.298	Stage 5		1640 Sand	Lift 1	Lot 1001	97	YES		
6/05/2022	0764_001 (0771/22)	3	309	395947.121	812048.549	Stage 5		1560 sand	Lift 2	Lot 1001	104	YES		
6/05/2022	0764_001 (0771/22)	4	310	395934.676	812035.298	Stage 5		1560 sand	Lift 2	Lot 1001	101	YES		
6/09/2022	1480 (1480/22)	1	933	395930.797	812059.341	Stage 5		1640 Sand	Final Lift	Lot 1002	99	YES		
6/09/2022	1480 (1480/22)	2	934	395944.377	812061.151	Stage 5		1640 Sand	Final Lift	Lot 1002	101	YES		
6/09/2022	1480/22	1	903	395930.797	812059.341	Stage 5		1640 Sand	Lift 1?	Lot 1002	99	YES		
6/09/2022	1480/22	2	904	395944.377	812061.151	Stage 5		1640 Sand	Lift 1?	Lot 1002	101	YES		
6/09/2022	1480 (1480/22)	3	935	395942.588	812075.142	Stage 5		1640 Sand	Final Lift	Lot 1003	101	YES		
6/09/2022	1480 (1480/22)	4	936	395928.718	812082.847	Stage 5		1640 Sand	Final Lift	Lot 1003	100	YES		

Project Prestons South Subdivision
Project No. 235361
Date 29-Nov-19
Title Summary of Compaction

COORDINATES LINKED TO TAB										Pass (Yes/No)
Test Date	Test ID#	Test #	Unique ID#	mE	mN	Stage	MDD	Type	Lift #	
11/11/2020 1912-20		3	181	395928.718	812082.847	Stage 5		1640 Sand	Lift 1	YES
11/11/2020 1912-20		4	182	395942.189	812074.981	Stage 5		1640 Sand	Lift 1	YES
11/11/2020 1912-20		5	183	395942.423	812074.7	Stage 5		1640 Sand	Lift 1	YES
11/11/2020 1912-20		6	184	395928.305	812082.246	Stage 5		1640 Sand	Lift 1	YES
16/11/2020 1922-20		3	173	395941.204	812084.639	Stage 5		1600 Sand	Lift 2	YES
16/11/2020 1922-20		4	174	395929.511	812072.612	Stage 5		1600 Sand	Lift 2	YES
16/11/2020 1922-20		5	175	395942.588	812075.142	Stage 5		1600 Sand	Lift 2	YES
16/11/2020 1922-20		6	176	395928.175	812082.778	Stage 5		1600 Sand	Lift 2	YES
19/11/2020 1949-20		3	169	395928.847	812082.291	Stage 5		1600 Sand	Lift 3	YES
19/11/2020 1949-20		4	170	395942.177	812075.562	Stage 5		1600 Sand	Lift 3	YES
6/09/2022 1480/22		3	905	395929.511	812072.612	Stage 5		1640 Sand	Lift 4?	YES
6/09/2022 1480/22		4	906	395941.204	812084.639	Stage 5		1640 Sand	Lift 4?	YES
20/11/2020 KB20/0432		3	257	395951.877	812086.979	Stage 5		2320 Pitrun	Final Lift	YES
20/11/2020 KB20/0432		4	258	395964.724	812078.051	Stage 5		2320 Pitrun	Final Lift	YES
16/11/2020 KB20/0425		3	249	395948.969	812086.511	Stage 5		2320 Pitrun	Lift 1	YES
16/11/2020 KB20/0425		4	250	395950.472	812075.743	Stage 5		2320 Pitrun	Lift 1	YES
17/11/2020 KB20/0426		3	253	395949.602	812086.391	Stage 5		2320 Pitrun	Lift 2	YES
17/11/2020 KB20/0426		4	254	395950.964	812076.033	Stage 5		2320 Pitrun	Lift 2	YES
4/05/2022 0791_001 (0744/22)		5	745	395956.931	812038.227	Stage 5		1640 Sand	Lift 1	NO
4/05/2022 0791_001 (0744/22)		6	746	395969.742	812051.404	Stage 5		1640 Sand	Lift 1	YES
6/05/2022 0765_001 (0772/22)		1	316	395969.742	812051.404	Stage 5		1640 sand	Lift 1	99 Yes
6/05/2022 0765_001 (0772/22)		2	317	395956.931	812038.227	Stage 5		1640 sand	Lift 1	98 Yes
6/05/2022 0764_001 (0771/22)		1	307	395969.742	812051.404	Stage 5		1560 sand	Lift 2	99
6/05/2022 0764_001 (0771/22)		2	308	395956.931	812038.227	Stage 5		1560 sand	Lift 2	YES
4/05/2022 0791_001 (0744/22)		3	743	395958.958	812024.665	Stage 5		1640 Sand	Lift 1	YES
4/05/2022 0791_001 (0744/22)		4	744	395972.53	812031.451	Stage 5		1640 Sand	Lift 1	95
6/05/2022 0750_001 (0769/22)		5	324	395958.958	812024.665	Stage 5		1560 sand with some peat	Lift 2	YES
6/05/2022 0750_001 (0769/22)		6	325	395972.53	812031.451	Stage 5		1560 sand with some peat	Lift 2	YES
12/05/2022 0797_001 (0804/22)		3	755	395958.732	812018.244	Stage 5		1640 Sand	Lift 2	98
12/05/2022 0797_001 (0804/22)		4	756	395975.082	812024.884	Stage 5		1640 Sand	Lift 2	100
12/05/2022 0796_001 (0815/22)		3	759	395958.732	812018.244	Stage 5		1640 Sand	Lift 3 - final	YES
12/05/2022 0796_001 (0815/22)		4	760	395975.082	812024.884	Stage 5		1640 Sand	Lift 3 - final	YES
4/05/2022 0791_001 (0744/22)		11	751	395963.994	811995.611	Stage 5		1640 Sand	Final lift?	97
4/05/2022 0791_001 (0744/22)		12	752	395973.814	812012.514	Stage 5		1640 Sand	Lift 1	96
6/05/2022 0750_001 (0769/22)		7	326	395970.098	812013.27	Stage 5		1560 sand with some peat	Lift 2	YES
6/05/2022 0750_001 (0769/22)		8	327	395969.073	811995.345	Stage 5		1560 sand with some peat	Lift 2	YES
12/05/2022 0797_001 (0804/22)		1	753	395976.153	812009.461	Stage 5		1640 Sand	Lift 2	99
12/05/2022 0797_001 (0804/22)		2	754	395959.446	812012.817	Stage 5		1640 Sand	Lift 2	100
12/05/2022 0796_001 (0815/22)		1	757	395976.153	812009.461	Stage 5		1640 Sand	Lift 3 - final	YES
12/05/2022 0796_001 (0815/22)		2	758	395959.446	812012.817	Stage 5		1640 Sand	Lift 3 - final	YES
24/02/2023 1482_001(0253/23)		3	1071	395868.202	811940.204	Stage 5		2320 Sand	Lift 1	101
24/02/2023 1482_001(0253/23)		4	1072	395874.197	811958.125	Stage 5		2320 Sand	Lift 1	100
2/03/2023 KB23/0099		3	1075	395869.328	811941.444	Stage 5		2360 Pit Run	Lift 1	YES
2/03/2023 KB23/0099		4	1076	395875.072	811956.78	Stage 5		2360 Pit Run	Lift 1	YES
3/05/2023 KB23/0105		1	1077	395873.837	811942.819	Stage 5		2360 Pit Run	Lift 2	YES
3/05/2023 KB23/0105		2	1078	395869.49	811955.681	Stage 5		2360 Pit Run	Lift 2	99
6/03/2023 KB23/0106		1	1091	395886.552	811960.644	Stage 5		2360 Pit Run	Lift 1	98
6/03/2023 KB23/0106		2	1092	395895.075	811950.344	Stage 5		2360 Pit Run	Lift 1	YES
7/05/2023 KB23/0113		1	1093	395884.956	811952.568	Stage 5		2360 Pit Run	Lift 2	97
7/05/2023 KB23/0113		2	1094	395896.396	811952.086	Stage 5		2360 Pit Run	Lift 2	96
8/03/2023 KB23/0115		1	1095	395889.243	811958.844	Stage 5		2360 Pit Run	Lift 3	YES
8/03/2023 KB23/0115		2	1096	395892.249	811949.614	Stage 5		2360 Pit Run	Lift 3	YES
9/03/2023 KB23/0122		1	1097	395894.569	811960.242	Stage 5		2360 Pit Run	Lift 4	97
9/03/2023 KB23/0122		2	1098	395889.246	811946.033	Stage 5		2360 Pit Run	Lift 4	102

Project Prestons South Subdivision
Project No. 235361
Date 29-Nov-19
Title Summary of Compaction

COORDINATES LINKED TO TAB										Lift #	Lot ID	Compaction (%)	Retest	Pass (Yes/No)
Test Date	Test ID#	Test #	Unique ID#	mE	mN	Stage	MDD	Type						
17/03/2023	K823/0148	1	1137	395913.362	811962.044	Stage 5		2360 Pitrun	Final Lift	Lot 1015	97	YES		
17/03/2023	K823/0148	2	1138	395919.996	811954.156	Stage 5		2360 Pitrun	Final Lift	Lot 1015	95	YES		
13/03/2023	K823/0134	1				Stage 5		2330 Pitrun	Lift 1	Lot 1015	99	YES		
13/03/2023	K823/0134	2				Stage 5		2280 Pitrun	Lift 1	Lot 1015	97	YES		
14/03/2023	K823/0135	1				Stage 5		2390 Pitrun	Lift 2	Lot 1015	101	YES		
14/03/2023	K823/0135	2				Stage 5		2340 Pitrun	Lift 2	Lot 1015	99	YES		
14/03/2023	K823/0137	1				Stage 5		2290 Pitrun	Lift 3	Lot 1015	97	YES		
14/03/2023	K823/0137	2				Stage 5		2270 Pitrun	Lift 3	Lot 1015	96	YES		
17/03/2023	1771_001	1				Stage 5		2360 Pitrun		Lot 1015	96	YES		
17/03/2023	1771_001	2				Stage 5		2360 Pitrun		Lot 1015	95	YES		
17/03/2023	K823/0148	3	1139	395922.974	811942.403	Stage 5		2360 Pitrun	Final Lift	Lot 1016	95	YES		
17/03/2023	K823/0148	4	1140	395914.79	811929.381	Stage 5		2360 Pitrun	Final Lift	Lot 1016	95	YES		
14/03/2023	K823/0136	1				Stage 5		2300 Pitrun	Lift 1	Lot 1016	97	YES		
14/03/2023	K823/0136	2				Stage 5		2400 Pitrun	Lift 1	Lot 1016	102	YES		
14/03/2023	K823/0138	1				Stage 5		2400 Pitrun	Lift 2	Lot 1016	102	YES		
14/03/2023	K823/0138	2				Stage 5		2370 Pitrun	Lift 2	Lot 1016	100	YES		
17/03/2023	1771_001	3				Stage 5		2360 Pitrun		Lot 1016	95	YES		
17/03/2023	1771_001	4				Stage 5		2360 Pitrun		Lot 1016	95	YES		
14/06/2022	1202_001 (1000/22)	6	639	395936.965	811949.349	Stage 5		2320 Pitrun	Lift ?? (lift 1)	Lot 1017	100	YES		
3/05/2023	K823/0231	1				Stage 5		2360 Pitrun	Lift 1	Lot 1017	98	YES		
3/05/2023	K823/0231	2				Stage 5		2360 Pitrun	Lift 1	Lot 1017	97	YES		
4/05/2023	K823/0235	1				Stage 5		2360 Pitrun	Lift 2	Lot 1017	95	YES		
4/05/2023	K823/0235	2				Stage 5		2360 Pitrun	Lift 2	Lot 1017	95	YES		
20/03/2023	K823/0155	1	1141	395973.111	811947.795	Stage 5		2360 Pitrun	Final Lift	Lot 1018	97	YES		
20/03/2023	K823/0155	2	1142	395960.814	811964.306	Stage 5		2360 Pitrun	Final Lift	Lot 1018	98	YES		
14/06/2022	1202_001 (1000/22)	4	637	395963.811	811953.885	Stage 5		2320 Pitrun	Lift ??	Lot 1018	103	YES		
16/03/2023	1673_001	1	1133	395967.839	811965.797	Stage 5		1600 Sand	Lift 1	Lot 1018	97	YES		
16/03/2023	1673_001	2	1134	395964.2	811948.769	Stage 5		1600 Sand	Lift 1	Lot 1018	97	YES		
17/03/2023	1685_001	1	1135	395969.831	811966.075	Stage 5		1640 Sand	Lift 2	Lot 1018	100	YES		
17/03/2023	1685_001	2	1136	395965.262	811945.884	Stage 5		1640 Sand	Lift 2	Lot 1018	101	YES		
14/06/2022	1202_001 (1000/22)	5	638	395951.062	811951.311	Stage 5		2320 Pitrun	Lift ?? (lift 1)	Lot 1018 - Lot 1017	102	YES		
14/06/2022	1202_001 (1000/22)	2	635	395992.495	811965.163	Stage 5		2320 Pitrun	Lift ?? (likely lift 3)	Lot 1019	100	YES		
14/06/2022	1202_001 (1000/22)	3	636	395978.766	811957.808	Stage 5		2320 Pitrun	Lift ?? (likely lift 3)	Lot 1019	101	YES		
25/05/2021	0231_001 (1025/21)	11	386	395987.518	811957.068	Stage 5		1640 Sand (westend of stockpile)	Lift 1	Lot 1019	94 Yes	NO		
25/05/2021	0231_001 (1025/21)	12	387	395981.084	811969.259	Stage 5		1640 Sand (westend of stockpile)	Lift 1	Lot 1019	93 Yes	NO		
3/06/2021	0248_001 (1102/21)	13	374	395981.084	811969.259	Stage 5		1640 Sand (westend of stockpile)	Lift 1	Lot 1019	98	YES		
3/06/2021	0248_001 (1102/21)	14	375	395987.518	811957.068	Stage 5		1640 Sand (westend of stockpile)	Lift 1	Lot 1019	104	YES		
14/01/2022	K822/0003	13	871	395987.518	811957.068	Stage 5		2320 Pit Run	Lift 2	Lot 1019	99	YES		
14/01/2022	K822/0003	14	872	395981.084	811969.259	Stage 5		2320 Pit Run	Lift 2	Lot 1019	98	YES		
25/05/2021	0231_001 (1025/21)	9	384	395998.164	811977.251	Stage 5		1640 Sand (westend of stockpile)	Lift 1	Lot 1020	93 Yes	NO		
25/05/2021	0231_001 (1025/21)	10	385	396006.141	811971.558	Stage 5		1640 Sand (westend of stockpile)	Lift 1	Lot 1020	95	YES		
3/06/2021	0248_001 (1102/21)	11	372	396006.141	811971.558	Stage 5		1640 Sand (westend of stockpile)	Lift 1	Lot 1020	100	YES		
3/06/2021	0248_001 (1102/21)	12	373	395998.164	811977.251	Stage 5		1640 Sand (westend of stockpile)	Lift 1	Lot 1020	102	YES		
14/01/2022	K822/0003	11	869	395998.164	811977.251	Stage 5		2320 Pit Run	Lift 1	Lot 1020	97	YES		
14/01/2022	K822/0003	12	870	396006.141	811971.558	Stage 5		2320 Pit Run	Lift 1	Lot 1020	99	YES		
14/06/2022	1202_001 (1000/22)	1	634	396001.444	811974.602	Stage 5		2320 Pitrun	Lift 3	Lot 1020	100	YES		
25/05/2021	0231_001 (1025/21)	7	382	396017.037	811988.786	Stage 5		1640 Sand (westend of stockpile)	Lift 1	Lot 1021	94 Yes	NO		
25/05/2021	0231_001 (1025/21)	8	383	396003.785	811990.7	Stage 5		1640 Sand (westend of stockpile)	Lift 1	Lot 1021	94 Yes	NO		
3/06/2021	0248_001 (1102/21)	9	370	396003.785	811990.7	Stage 5		1640 Sand (westend of stockpile)	Lift 1	Lot 1021	99	YES		
3/06/2021	0248_001 (1102/21)	10	371	396017.037	811988.786	Stage 5		1640 Sand (westend of stockpile)	Lift 1	Lot 1021	100	YES		
14/01/2022	K822/0003	9	867	396017.593	812008.966	Stage 5		2320 Pit Run	Lift 2	Lot 1021	97	YES		
14/01/2022	K822/0003	10	868	396003.785	811990.7	Stage 5		2320 Pit Run	Lift 2	Lot 1021	99	YES		
25/05/2021	0231_001 (1025/21)	5	380	396017.593	812008.966	Stage 5		1640 Sand (westend of stockpile)	Lift 1	Lot 1022	92 Yes	NO		
25/05/2021	0231_001 (1025/21)	6	381	396003.458	812007.641	Stage 5		1640 Sand (westend of stockpile)	Lift 1	Lot 1022	95	YES		

Project Prestons South Subdivision
Project No. 235361
Date 29-Nov-19
Title Summary of Compaction

COORDINATES LINKED TO TAB													
Test Date	Test ID#	Test #	Unique ID#	mE	mN	Stage	MDD	Type	Lift #	Lot ID	Compaction (%)	Retest	Pass (Yes/No)
3/06/2021 0248_001 (1102/21)		7	368 396017.593	812008.966	Stage 5	1640 Sand (westend of stockpile)	Lift 1	1640 Sand (westend of stockpile)	Lift 1	Lot 1022	106		YES
3/06/2021 0248_001 (1102/21)		8	369 396003.458	812007.641	Stage 5	1640 Sand (westend of stockpile)	Lift 1	1640 Sand (westend of stockpile)	Lift 1	Lot 1022	103		YES
16/06/2021 1312_001 (1190/21)		3	342 396016.785	812013.475	Stage 5	1640 Sand	Lift 2	1640 Sand	Lift 2	Lot 1022	100		YES
16/06/2021 1312_001 (1190/21)		4	343 396004.413	812002.64	Stage 5	1640 Sand	Lift 2	1640 Sand	Lift 2	Lot 1022	99		YES
14/01/2022 KB22/0003		7	865 396003.458	812007.641	Stage 5	2320 Pit Run	Lift 3	2320 Pit Run	Lift 3	Lot 1022	99		YES
14/01/2022 KB22/0003		8	866 396017.593	812008.966	Stage 5	2320 Pit Run	Lift 3	2320 Pit Run	Lift 3	Lot 1022	97		YES
25/05/2021 0231_001 (1025/21)		3	378 396000.513	812025.457	Stage 5	1640 Sand (westend of stockpile)	Lift 1	1640 Sand (westend of stockpile)	Lift 1	Lot 1023	93 Yes		NO
25/05/2021 0231_001 (1025/21)		4	379 396014.354	812027.372	Stage 5	1640 Sand (westend of stockpile)	Lift 1	1640 Sand (westend of stockpile)	Lift 1	Lot 1023	95		YES
16/06/2021 0248_001 (1102/21)		5	366 396000.513	812025.457	Stage 5	1640 Sand (westend of stockpile)	Lift 1	1640 Sand (westend of stockpile)	Lift 1	Lot 1023	104		YES
3/06/2021 0248_001 (1102/21)		6	367 396014.354	812027.372	Stage 5	1640 Sand (westend of stockpile)	Lift 1	1640 Sand (westend of stockpile)	Lift 1	Lot 1023	108		YES
14/01/2022 KB22/0003		5	863 396012.293	812044.01	Stage 5	2320 Pit Run	Lift 1	2320 Pit Run	Lift 1	Lot 1023	97		YES
14/01/2022 KB22/0003		6	864 396000.513	812025.457	Stage 5	2320 Pit Run	Lift 1	2320 Pit Run	Lift 1	Lot 1023	96		YES
14/06/2021 0415_001 (1174/21)		3	346 395999.674	812029.475	Stage 5	1640 Sand (westend of stockpile)	Lift 2	1640 Sand (westend of stockpile)	Lift 2	Lot 1023	106		YES
14/06/2021 0415_001 (1174/21)		4	347 396014.634	812021.2	Stage 5	1640 Sand (westend of stockpile)	Lift 2	1640 Sand (westend of stockpile)	Lift 2	Lot 1023	104		YES
16/06/2021 1312_001 (1190/21)		1	340 396013.71	812031.19	Stage 5	1640 Sand	Lift 3	1640 Sand	Lift 3	Lot 1023	99		YES
16/06/2021 1312_001 (1190/21)		2	341 396001.485	812019.843	Stage 5	1640 Sand	Lift 3	1640 Sand	Lift 3	Lot 1023	99		YES
25/05/2021 0231_001 (1025/21)		1	376 396012.293	812044.01	Stage 5	1640 Sand (westend of stockpile)	Lift 1	1640 Sand (westend of stockpile)	Lift 1	Lot 1024	93 Yes		NO
25/05/2021 0231_001 (1025/21)		2	377 395996.979	812042.538	Stage 5	1640 Sand (westend of stockpile)	Lift 1	1640 Sand (westend of stockpile)	Lift 1	Lot 1024	93 Yes		NO
3/06/2021 0248_001 (1102/21)		3	364 396012.293	812044.01	Stage 5	1640 Sand (westend of stockpile)	Lift 1	1640 Sand (westend of stockpile)	Lift 1	Lot 1024	106		YES
3/06/2021 0248_001 (1102/21)		4	365 395996.979	812042.538	Stage 5	1640 Sand (westend of stockpile)	Lift 1	1640 Sand (westend of stockpile)	Lift 1	Lot 1024	101		YES
14/06/2021 0415_001 (1174/21)		1	344 395996.428	812046.981	Stage 5	1640 Sand (westend of stockpile)	Lift 2	1640 Sand (westend of stockpile)	Lift 2	Lot 1024	99		YES
14/06/2021 0415_001 (1174/21)		2	345 396012.915	812037.814	Stage 5	1640 Sand (westend of stockpile)	Lift 2	1640 Sand (westend of stockpile)	Lift 2	Lot 1024	104		YES
14/01/2022 KB22/0003		3	861 395996.979	812042.538	Stage 5	2320 Pit Run	Lift 3	2320 Pit Run	Lift 3	Lot 1024	98		YES
14/01/2022 KB22/0003		4	862 396012.293	812044.01	Stage 5	2320 Pit Run	Lift 3	2320 Pit Run	Lift 3	Lot 1024	97		YES
14/01/2022 KB22/0003		1	859 396010.208	812060.324	Stage 5	2320 Pit Run	Lift 1	2320 Pit Run	Lift 1	Lot 1025	100		YES
14/01/2022 KB22/0003		2	860 395996.204	812058.427	Stage 5	2320 Pit Run	Lift 1	2320 Pit Run	Lift 1	Lot 1025	100		YES
12/05/2020 KB20/0149		7	137 396006.798	812077.059	Stage 5	2320 Pitrun	Lift 1	2320 Pitrun	Lift 1	Lot 1026	100		YES
12/05/2020 KB20/0149		8	138 395992.479	812075.367	Stage 5	2320 Pitrun	Lift 1	2320 Pitrun	Lift 1	Lot 1026	99		YES
13/05/2020 KB20/0158		4	142 396006.798	812077.059	Stage 5	2320 Pitrun	Lift 2	2320 Pitrun	Lift 2	Lot 1026	99		YES
13/05/2020 KB20/0158		5	143 395992.479	812075.367	Stage 5	2320 Pitrun	Lift 2	2320 Pitrun	Lift 2	Lot 1026	101		YES
12/05/2020 KB20/0149		5	135 395990.656	812091.769	Stage 5	2320 Pitrun	Lift 1	2320 Pitrun	Lift 1	Lot 1027	99		YES
12/05/2020 KB20/0149		6	136 396004.455	812094.112	Stage 5	2320 Pitrun	Lift 1	2320 Pitrun	Lift 1	Lot 1027	100		YES
13/05/2020 KB20/0158		3	141 396004.455	812094.112	Stage 5	2320 Pitrun	Lift 2	2320 Pitrun	Lift 2	Lot 1027	99		YES
13/05/2020 KB20/0158		6	144 395990.656	812091.769	Stage 5	2320 Pitrun	Lift 2	2320 Pitrun	Lift 2	Lot 1027	99		YES
20/07/2022 2039_001 (1209/22)		11	803 395857.559	811979.441	Stage 5	1640 Sand	Lift 2	1640 Sand	Lift 2	Lot 962	106		YES
20/07/2022 2039_001 (1209/22)		12	804 395850.117	811996.923	Stage 5	1640 Sand	Lift 2	1640 Sand	Lift 2	Lot 962	107		YES
12/08/2022 KB22/0312		7	785 395820.578	812069.547	Stage 5	2320 Pit run	Lift 1	2320 Pit run	Lift 1	Lot 983	98		YES
12/08/2022 KB22/0312		8	786 395830.421	812076.415	Stage 5	2320 Pit run	Lift 1	2320 Pit run	Lift 1	Lot 983	97		YES
22/08/2022 KB22/0324		7	841 395820.578	812069.547	Stage 5	2320 Pit Run	Lift 2	2320 Pit Run	Lift 2	Lot 983	97		YES
22/08/2022 KB22/0324		8	842 395830.421	812076.415	Stage 5	2320 Pit Run	Lift 2	2320 Pit Run	Lift 2	Lot 983	95		YES
15/09/2022 KB22/0384		1	925 395832.989	812070.124	Stage 5	2320 Pit Run	Lift 3	2320 Pit Run	Lift 3	Lot 983	100		YES
15/09/2022 KB22/0384		2	926 395815.99	812079.478	Stage 5	2320 Pit Run	Lift 3	2320 Pit Run	Lift 3	Lot 983	98		YES
27/02/2023 KB23/0089		9	1089 395829.702	812046.923	Stage 5	2360 Pit Run	Final Lift	2360 Pit Run	Final Lift	Lot 984	97		YES
27/02/2023 KB23/0089		10	1090 395833.457	812059.191	Stage 5	2360 Pit Run	Final Lift	2360 Pit Run	Final Lift	Lot 984	96		YES
18/08/2022 KB22/0322		1	1121 395832.698	812048.047	Stage 5	2320 Pitrun	Lift 1	2320 Pitrun	Lift 1	Lot 984	95		YES
18/08/2022 KB22/0322		2	1122 395828.314	812057.061	Stage 5	2320 Pitrun	Lift 1	2320 Pitrun	Lift 1	Lot 984	95		YES
12/10/2022 KB22/0429		1	1044 395837.102	812054.32	Stage 5	2320 Pit Run	Lift 2	2320 Pit Run	Lift 2	Lot 984	97		YES
12/10/2022 KB22/0429		2	1045 395825.272	812049.794	Stage 5	2320 Pit Run	Lift 2	2320 Pit Run	Lift 2	Lot 984	97		YES
20/01/2022 3073_001 (0052/22)		1	332 395836.262	812040.107	Stage 5	1640 Sand (westend of stockpile)	Final Lift	1640 Sand (westend of stockpile)	Final Lift	Lot 985	99		YES
20/01/2022 3073_001 (0052/22)		2	333 395840.555	812024.364	Stage 5	1640 Sand (westend of stockpile)	Final Lift	1640 Sand (westend of stockpile)	Final Lift	Lot 985	101		YES
27/02/2023 KB23/0089		7	1087 395843.188	812038.852	Stage 5	2360 Pit Run	Final Lift	2360 Pit Run	Final Lift	Lot 985	99		YES
27/02/2023 KB23/0089		8	1088 395833.906	812036.039	Stage 5	2360 Pit Run	Final Lift	2360 Pit Run	Final Lift	Lot 985	96		YES
1/09/2022 KB22/0344		3	919 395835.727	812021.719	Stage 5	2320 Pit Run	Lift 1	2320 Pit Run	Lift 1	Lot 985	98		YES
1/09/2022 KB22/0344		4	920 395847.295	812026.648	Stage 5	2320 Pit Run	Lift 1	2320 Pit Run	Lift 1	Lot 985	100		YES


Project Prestons South Subdivision
Project No. 235361
Date 29-Nov-19
Title Summary of Compaction

COORDINATES LINKED TO TAB													
Test Date	Test ID#	Test #	Unique ID#	mE	mN	Stage	MDD	Type	Lift #	Lot ID	Compaction (%)	Retest	Pass (Yes/No)
2/09/2022	K822/0346	3	923	395835.727	812021.719	Stage 5		2320 Pit Run	Lift 2	Lot 985	99		YES
2/09/2022	K822/0346	4	924	395847.295	812026.648	Stage 5		2320 Pit Run	Lift 2	Lot 985	98		YES
12/10/2022	K822/0429	7	1050	395829.639	812037.249	Stage 5		2320 Pit Run	Lift 2	Lot 985	99		YES
12/10/2022	K822/0429	8	1051	395836.262	812040.107	Stage 5		2320 Pit Run	Lift 2	Lot 985	99		YES
20/01/2022	3073_001 (0052/22)	3	334	395842.828	812017.713	Stage 5		1640 Sand (westend of stockpile)	Final Lift	Lot 986	101		YES
20/01/2022	3073_001 (0052/22)	4	335	395847.795	812004.832	Stage 5		1640 Sand (westend of stockpile)	Final Lift	Lot 986	98		YES
12/05/2021	1713_001 (0937/21)	9	1117	395851.772	812009.169	Stage 5		1640 Sand	Lift 1	Lot 986	97		YES
12/05/2021	1713_001 (0937/21)	10	1118	395841.278	812013.088	Stage 5		1640 Sand	Lift 1	Lot 986	98		YES
20/05/2021	0242_001 (0991/21)	1	348	395850.26	812021.588	Stage 5		1640 Sand (westend of stockpile)	Lift 2	Lot 986	98		YES
20/05/2021	0242_001 (0991/21)	2	349	395841.768	812002.042	Stage 5		1640 Sand (westend of stockpile)	Lift 2	Lot 986	100		YES
4/05/2022	743/22	5				Stage 5		1530 Sand	Lift 1	Lot 987	93		NO
4/05/2022	743/22	6				Stage 5		1560 Sand	Lift 1	Lot 987	95		YES
6/05/2022	0752_001 (0770/22)	5	313	395887.017	812008.574	Stage 5		1560 sand	Lift 1	Lot 987	103		YES
4/05/2022	743/22	7				Stage 5		1550 Sand	Lift 1	Lot 988	94		NO
4/05/2022	743/22	8				Stage 5		1540 Sand	Lift 1	Lot 988	94		NO
6/05/2022	0752_001 (0770/22)	7	314	395889.194	812018.817	Stage 5		1560 sand	Lift 1	Lot 988	102		YES
6/05/2022	0752_001 (0770/22)	8	315	395874.598	812027.779	Stage 5		1560 sand	Lift 1	Lot 988	102		YES
02/22/2022	K822/0483	9	1065	395871.202	812041.689	Stage 5		2320 Pit Run	Lift 1	Lot 989	95		YES
02/22/2022	K822/0483	10	1066	395882.282	812045.456	Stage 5		2320 Pit Run	Lift 1	Lot 989	97		YES
12/05/2023	K823/0258	1				Stage 5		2380 Pitrun	Lift 2	Lot 989	96		YES
12/05/2023	K823/0258	2				Stage 5		2380 Pitrun	Lift 2	Lot 989	98		YES
18/05/2023	K823/0268	1	1149	395882.226	812042.894	Stage 5		2380 Pitrun	Lift 3	Lot 989	96		YES
18/05/2023	K823/0268	6	1154	395872.748	812038.915	Stage 5		2380 Pitrun	Lift 3	Lot 989	96		YES
02/22/2022	K822/0483	7	1063	395875.08	812064.403	Stage 5		2320 Pit Run	Lift 1	Lot 990	98		YES
02/22/2022	K822/0483	8	1064	395865.33	812060.082	Stage 5		2320 Pit Run	Lift 1	Lot 990	97		YES
12/05/2023	K823/0258	3				Stage 5		2380 Pitrun	Lift 2	Lot 990	96		YES
12/05/2023	K823/0258	4				Stage 5		2380 Pitrun	Lift 2	Lot 990	97		YES
18/05/2023	K823/0268	2	1150	395875.008	812068.385	Stage 5		2380 Pitrun	Lift 3	Lot 990	95		YES
18/05/2023	K823/0268	5	1153	395866.164	812057.504	Stage 5		2380 Pitrun	Lift 3	Lot 990	95		YES
02/22/2022	K822/0483	1	1057	395857.353	812079.915	Stage 5		2320 Pit Run	Lift 1	Lot 991	96		YES
02/22/2022	K822/0483	2	1058	395872.089	812082.906	Stage 5		2320 Pit Run	Lift 1	Lot 991	100		YES
12/05/2023	K823/0258	5				Stage 5		2380 Pitrun	Lift 2	Lot 991	98		YES
12/05/2023	K823/0258	6				Stage 5		2380 Pitrun	Lift 2	Lot 991	100		YES
18/05/2023	K823/0268	3	1151	395871.01	812085.072	Stage 5		2380 Pitrun	Lift 3	Lot 991	97		YES
18/05/2023	K823/0268	4	1152	395858.775	812077.684	Stage 5		2380 Pitrun	Lift 3	Lot 991	96		YES
02/22/2022	K822/0483	3	1059	395882.282	812084.125	Stage 5		2320 Pit Run	Lift 1	Lot 994	95		YES
02/22/2022	K822/0483	4	1060	395899.788	812085.565	Stage 5		2320 Pit Run	Lift 1	Lot 994	95		YES
8/05/2023	K823/0247	5				Stage 5		2360 Pitrun	Lift 2	Lot 994	97		YES
8/05/2023	K823/0247	6				Stage 5		2360 Pitrun	Lift 2	Lot 994	96		YES
17/05/2023	K823/0262	5	1147	395885.058	812080.719	Stage 5		2380 Pitrun	Lift 3	Lot 994	97		YES
17/05/2023	K823/0262	6	1148	395900.316	812081.267	Stage 5		2380 Pitrun	Lift 3	Lot 994	96		YES
02/22/2022	K822/0483	5	1061	395901.229	812067.727	Stage 5		2320 Pit Run	Lift 1	Lot 995	101		YES
02/22/2022	K822/0483	6	1062	395888.044	812066.84	Stage 5		2320 Pit Run	Lift 1	Lot 995	95		YES
8/05/2023	K823/0247	3				Stage 5		2360 Pitrun	Lift 2	Lot 995	99		YES
8/05/2023	K823/0247	4				Stage 5		2360 Pitrun	Lift 2	Lot 995	100		YES
17/05/2023	K823/0262	3	1145	395901.777	812065.644	Stage 5		2380 Pitrun	Lift 3	Lot 995	98		YES
17/05/2023	K823/0262	4	1146	395889.626	812063.086	Stage 5		2380 Pitrun	Lift 3	Lot 995	96		YES
02/22/2022	K822/0483	11	1067	395891.035	812048.337	Stage 5		2320 Pit Run	Lift 1	Lot 996	98		YES
02/22/2022	K822/0483	12	1068	395906.326	812049.667	Stage 5		2320 Pit Run	Lift 1	Lot 996	100		YES
8/05/2023	K823/0247	1				Stage 5		2360 Pitrun	Lift 2	Lot 996	99		YES
8/05/2023	K823/0247	2				Stage 5		2360 Pitrun	Lift 2	Lot 996	98		YES
17/05/2023	K823/0262	1	1143	395892.732	812044.148	Stage 5		2380 Pitrun	Lift 3	Lot 996	96		YES
17/05/2023	K823/0262	2	1144	395906.711	812046.889	Stage 5		2380 Pitrun	Lift 3	Lot 996	97		YES
4/05/2022	743/22	1				Stage 5		1600 Sand	Lift 1	Lot 997	98		YES

Project Prestons South Subdivision
Project No. 235361
Date 29-Nov-19
Title Summary of Compaction


COORDINATES LINKED TO TAB									
Test Date	Test ID#	Test #	Unique ID#	mE	mN	Stage	MDD	Type	Lift #
4/05/2022	743/22	2				Stage 5		1580 Sand	Lift 1
6/05/2022	0750_001 (0769/22)	1	320	395908.64	812022.873	Stage 5		1560 sand with some peat	Lift 2
6/05/2022	0750_001 (0769/22)	2	321	395895.964	812034.396	Stage 5		1560 sand with some peat	Lift 2
4/05/2022	743/22	3				Stage 5		1550 Sand	Lift 1
4/05/2022	743/22	4				Stage 5		1530 Sand	Lift 1
6/05/2022	0752_001 (0770/22)	3	311	395903.022	812012.287	Stage 5		1560 sand	Lift 1
6/05/2022	0752_001 (0770/22)	4	312	395911.344	811990.777	Stage 5		1560 sand	Lift 1
6/05/2022	0765_001 (0772/22)	3	318	395951.404	812009.301	Stage 5		1560 sand	Final Lift
6/05/2022	0765_001 (0772/22)	4	319	395943.85	811990.479	Stage 5		1560 sand	Final Lift
4/05/2022	0791_001 (0744/22)	9	749	395939.726	812007.226	Stage 5		1640 Sand	Final lift?
4/05/2022	0791_001 (0744/22)	10	750	395954.268	811993.912	Stage 5		1640 Sand	Final lift?

Lot ID	Compaction (%)	Retest	Pass (Yes/No)
Lot 997	96		YES
Lot 997	103		YES
Lot 997	103		YES
Lot 998	94		NO
Lot 998	93		NO
Lot 998	101		YES
Lot 998	101		YES
Lot 999	102		YES
Lot 999	101		YES
Lot 999	95		YES
Lot 999	93		NO

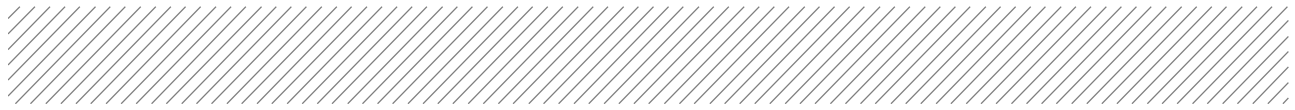

Appendix D

Gravel Embankment Design and As-Builts

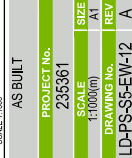

PROJECT	PRESTONS PARK
TITLE	STAGE 5 GRAVEL EMBANKMENT AS BUILT PLAN

DRAWN	DESIGNED
A. COLUMBUS	M. CROWE
CHECKED	
APPROVED	
DATE	





	REV	DATE	REVISION DETAILS	APPROVED
A.	20/10/22		AS BUILT ISSUED	



CDL LAND
NEW ZEALAND LIMITED

aurecon
www.aurecongroup.com


CDLAND
NEW ZEALAND LIMITED

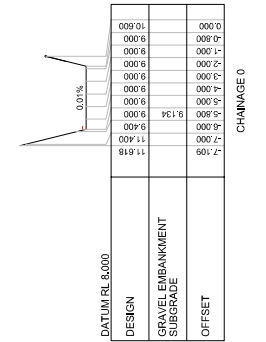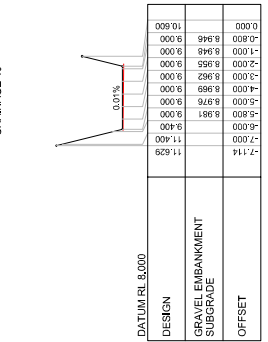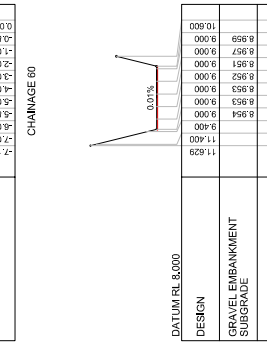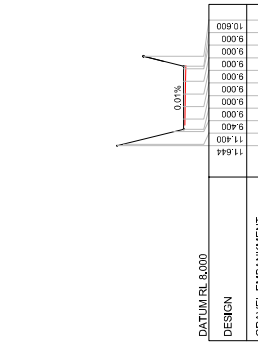


PROJECT	TITLE
PRESTONS PARK	STAGE 5 GRAVEL EMBANKMENT AS BUILT CROSS SECTION SHEET 1 OF 2

REV	DATE	REVISION DETAILS	APPROVED	DRAWN A. COLUMBUS	DESIGNED M. CROWE
				CHECKED	
				APPROVED	DATE




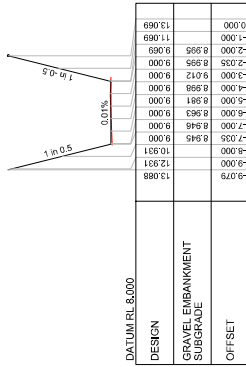


CHAINAGE 360

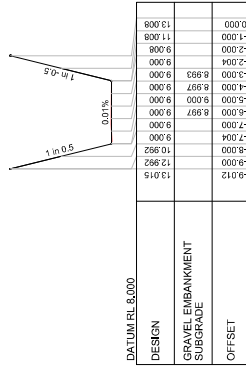


CHAINAGE 360

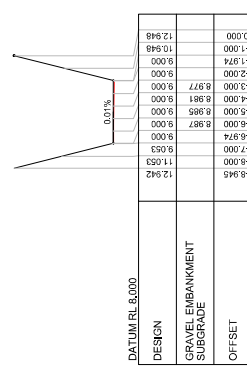


CHAINAGE 340

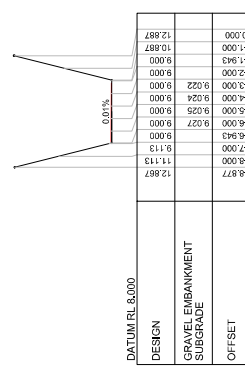


CHAINAGE 320

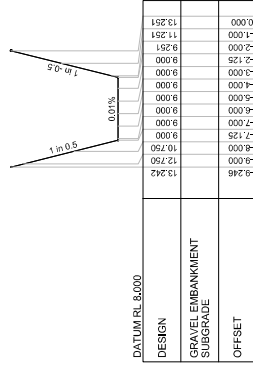

CHAINAGE 430,739

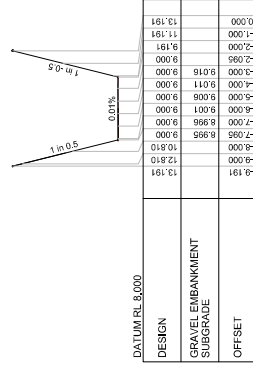

CHAINAGE 420

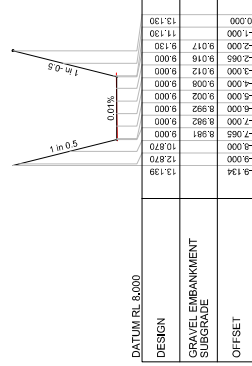

CHAINAGE 400