


CCC Advice Note
 Stages Q5, R3, S3, T4 & T5 only



aurecon
 www.aurecongroup.com

CLIENT

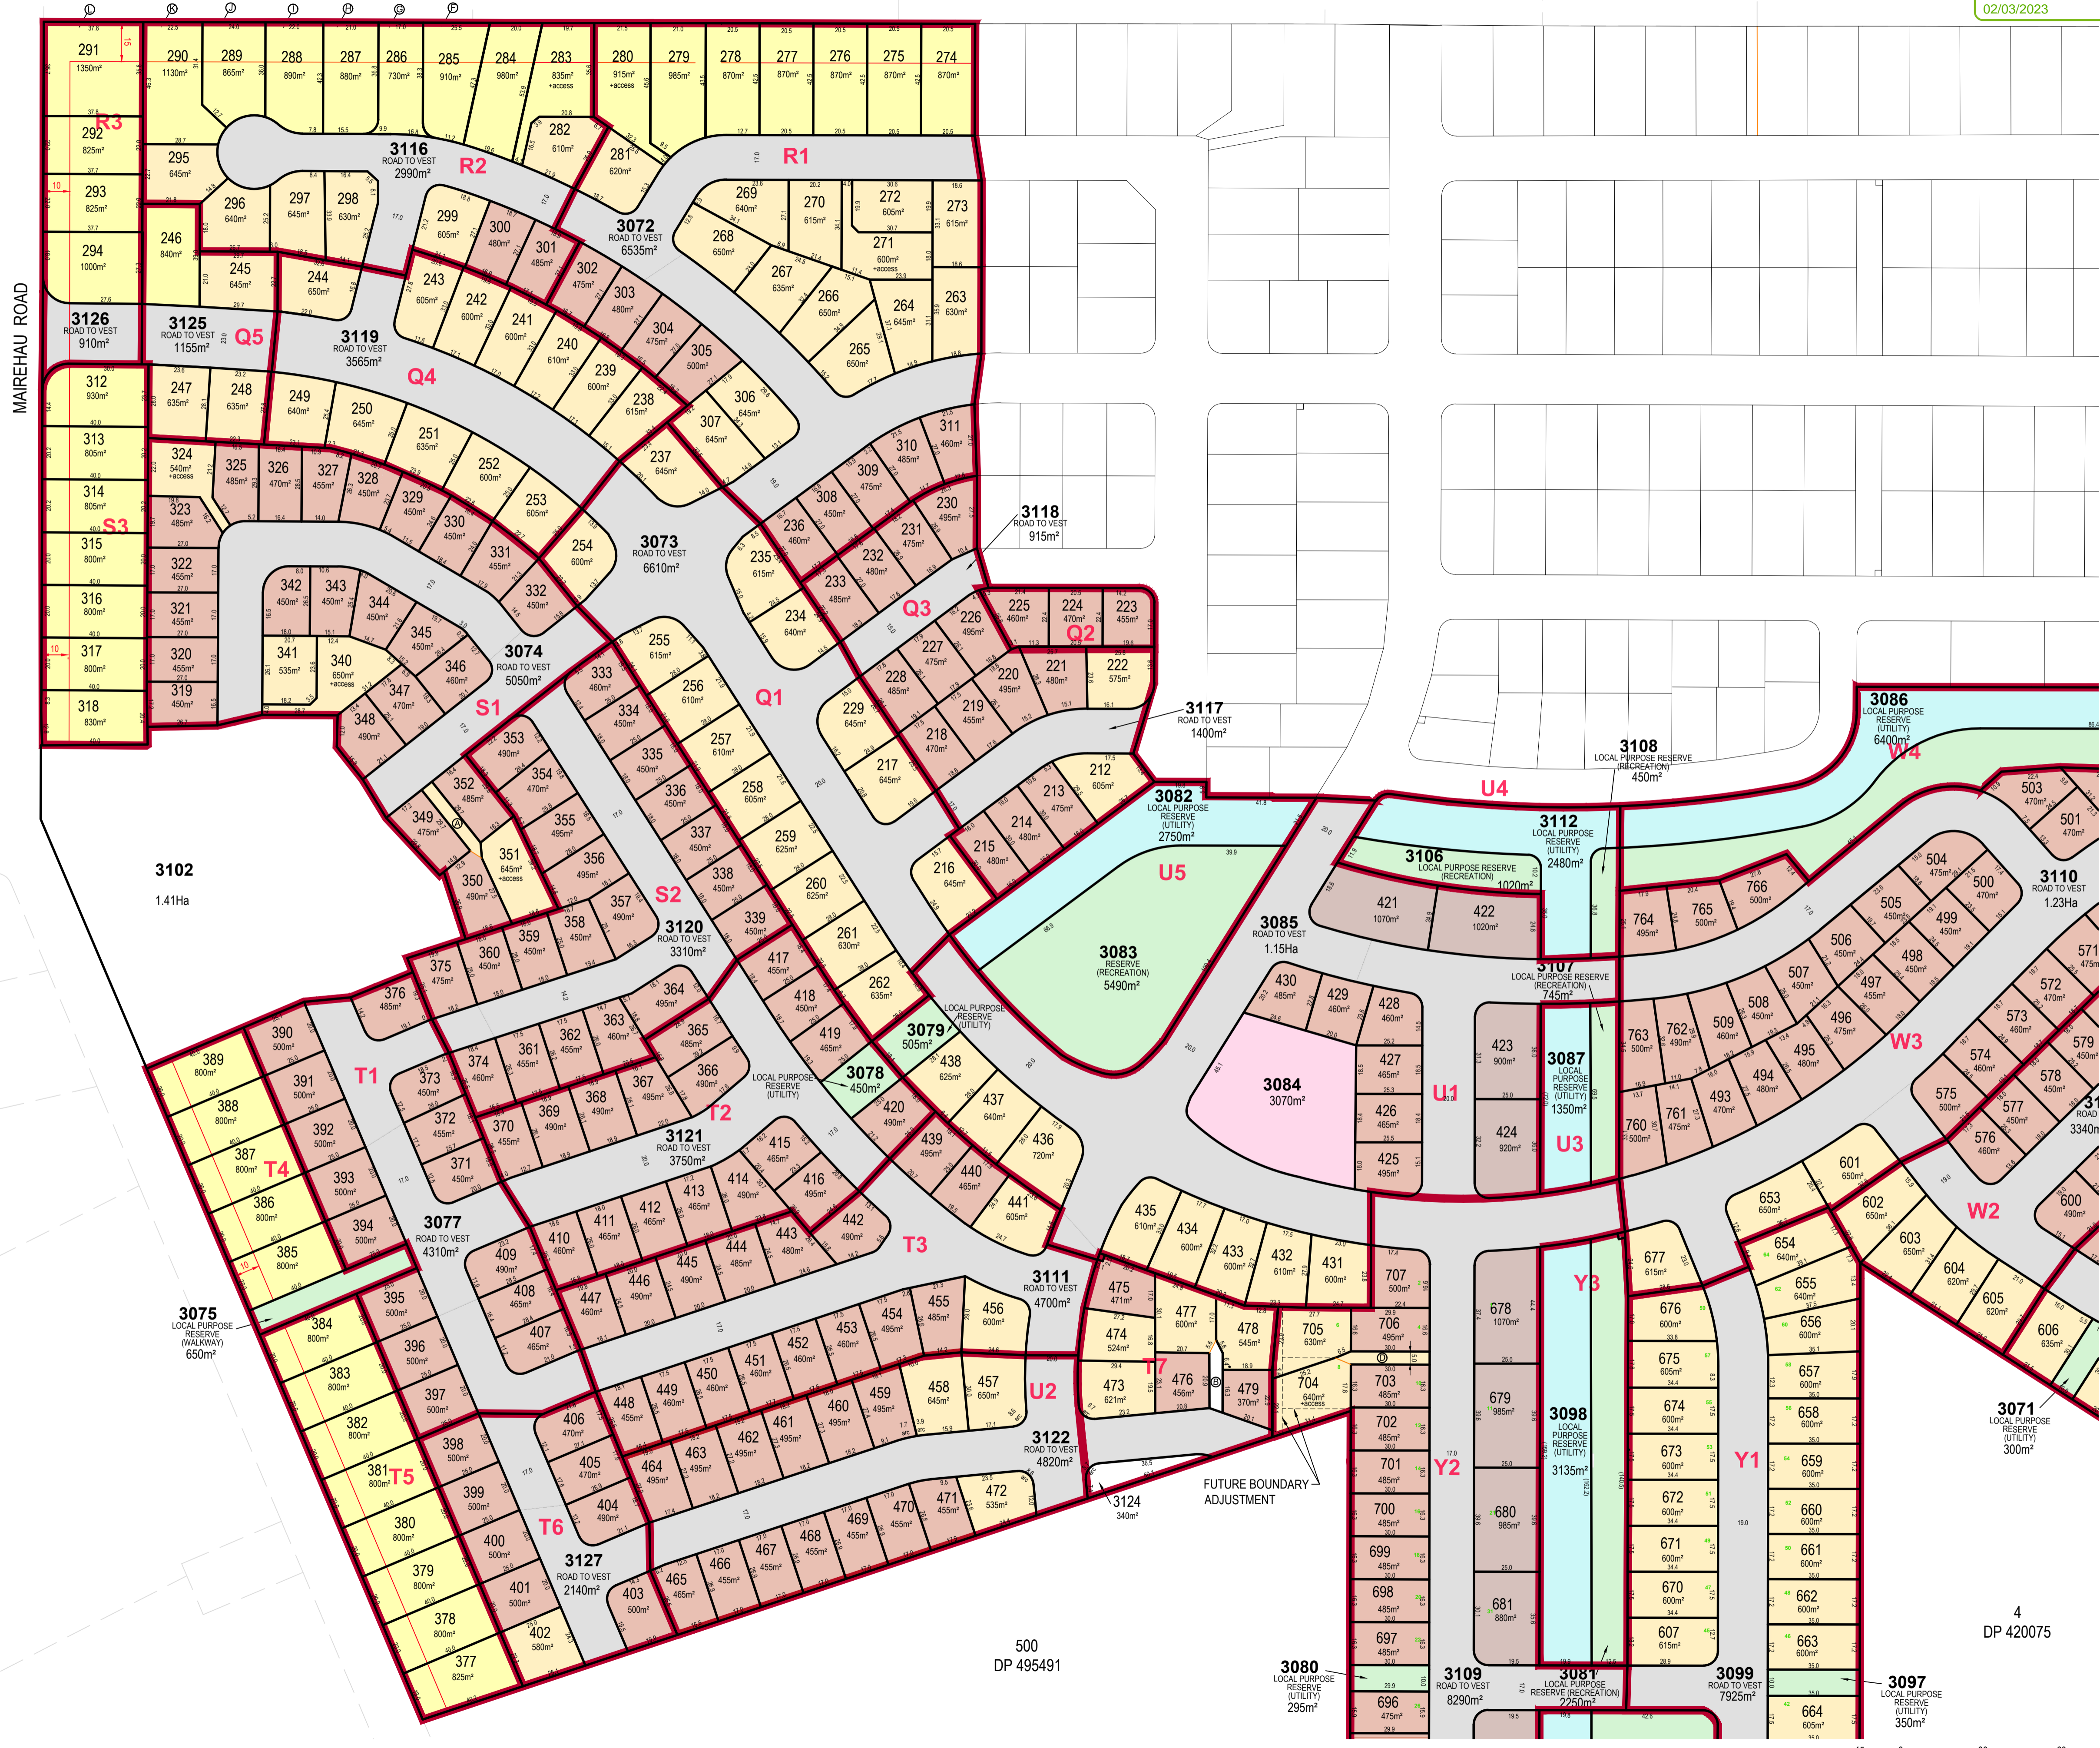

CDL LAND
 NEW ZEALAND LIMITED

REV	DATE	REVISION DETAILS	APPROVED
M	3/10/18	REISSUE FOR CONSENT - STAGES T3 & U2	K ASHBY
L	30/05/18	REISSUE FOR CONSENT	K ASHBY
K	13/03/18	REISSUE FOR CONSENT - VARIOUS	K ASHBY
J	27/09/17	LOTS 3099 & 3123 (SHEET 3)	K ASHBY
I	04/10/16	STAGES Q-U	K ASHBY
H	03/10/16	STAGE Q2	K ASHBY
G	21/06/16	VARIOUS FOR CONSENT	K ASHBY
F	08/04/16	VARIOUS - STAGES U,W,X,Y	K ASHBY

PROJECT

PRESTONS PARK

TITLE

PROPOSED SUBDIVISION OF
 LOT 3030 RMA 92022389

SHEET 2

DRAWN: R DAWSON, DESIGNED: K ASHBY, FOR CONSENT

CHECKED: A GREIG, PROJECT No. 235361

APPROVED: K.A. Ashby, DATE: 08/06/13, SCALE: 1:1250, SIZE: A1

K ASHBY, DRAWING No. SU-MP-S2-SP-02.2, REV: M

